


T.17S. R.12W. W. M.

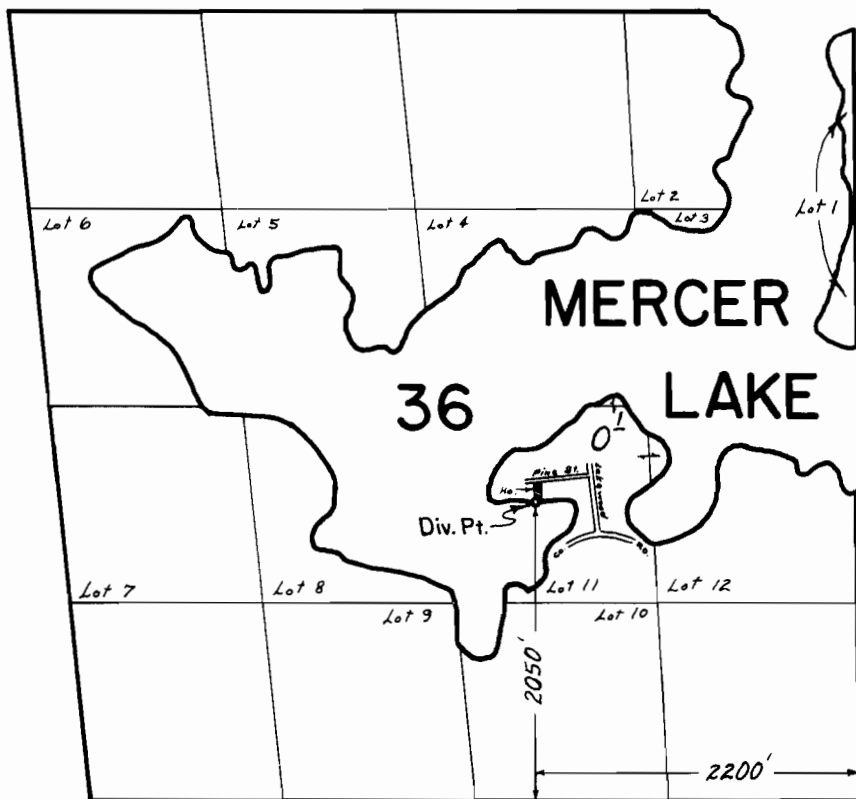

FINAL PROOF SURVEY
UNDER

Application No. 46104 Permit No. 34446
IN NAME OF

IRA G. & FLORENCE L. RICHARDSON

Surveyed JULY 10, 1974, by L. E. GOULD