


T.16S. R.6W. W. M.

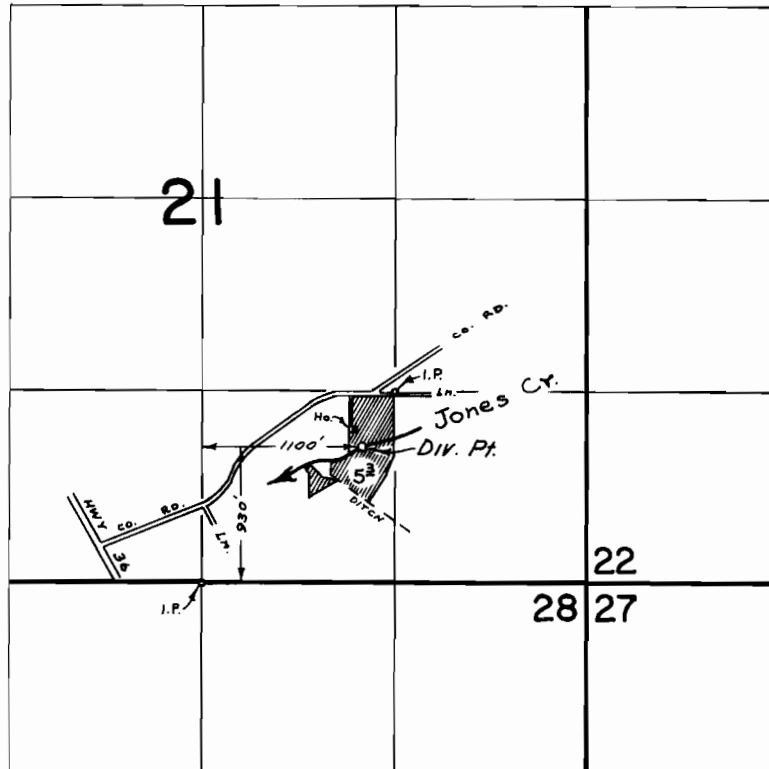

FINAL PROOF SURVEY
UNDER

Application No. 47108 Permit No. 35273
IN NAME OF
JESSE W. BOLING

Surveyed April 29, 1975, by R. MUCKEN