


T.13S. R.10W. W.M.

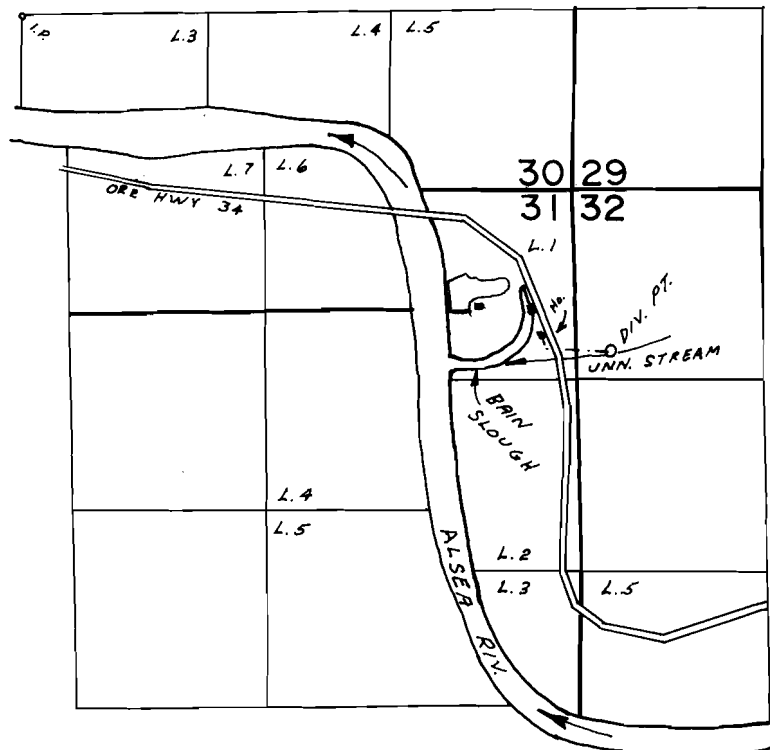

DIV. PT. LOC. 1110' S. & 250' E. FROM NW COR. SEC. 32

FINAL PROOF SURVEY UNDER

Application No. 50142 Permit No. 36792
IN NAME OF

LUCILLE CARTER

Surveyed JUN. 6 1974, by L.H. NUNN