


T.11S., R.3W., W.M.

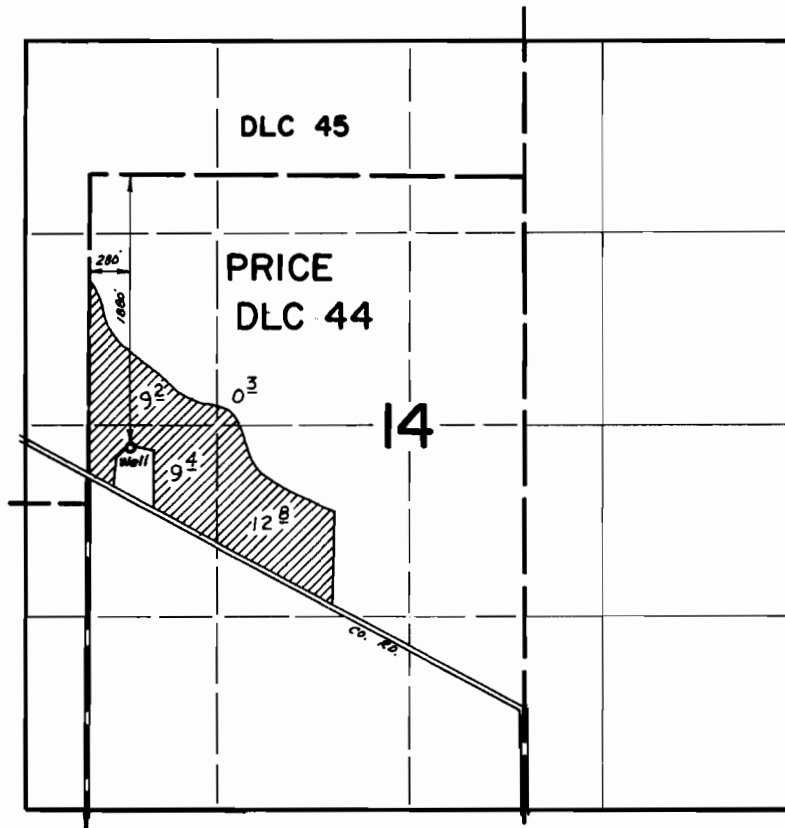

**FINAL PROOF SURVEY**  
UNDER

Application No. G-3534 Permit No. G-3326  
IN NAME OF

DANIEL M. AND IRVA L. ROPP

Surveyed Sept. 3 1975, by D. Norby