


T.1S.,R.2W.,W.M.

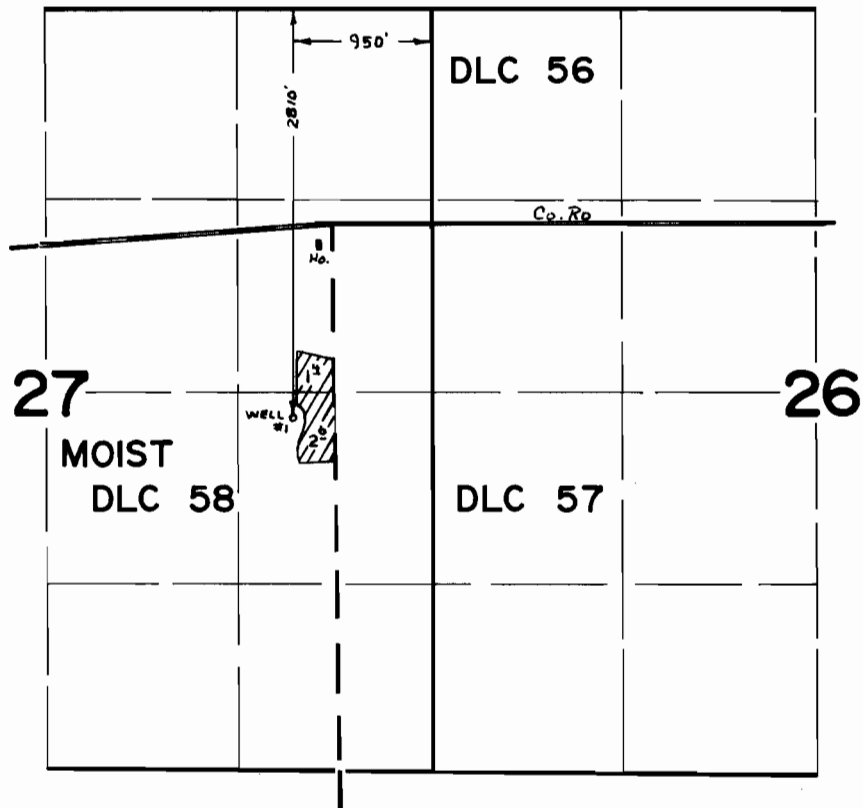

**FINAL PROOF SURVEY**  
UNDER

Application No. ~~G-4698~~ Permit No. ~~G-4416~~  
IN NAME OF

..... **IVAN & RETA AYERS** .....

Surveyed Oct. 15, 1974, by L. Toll .....