


T.10&11S., R.1W., W.M.

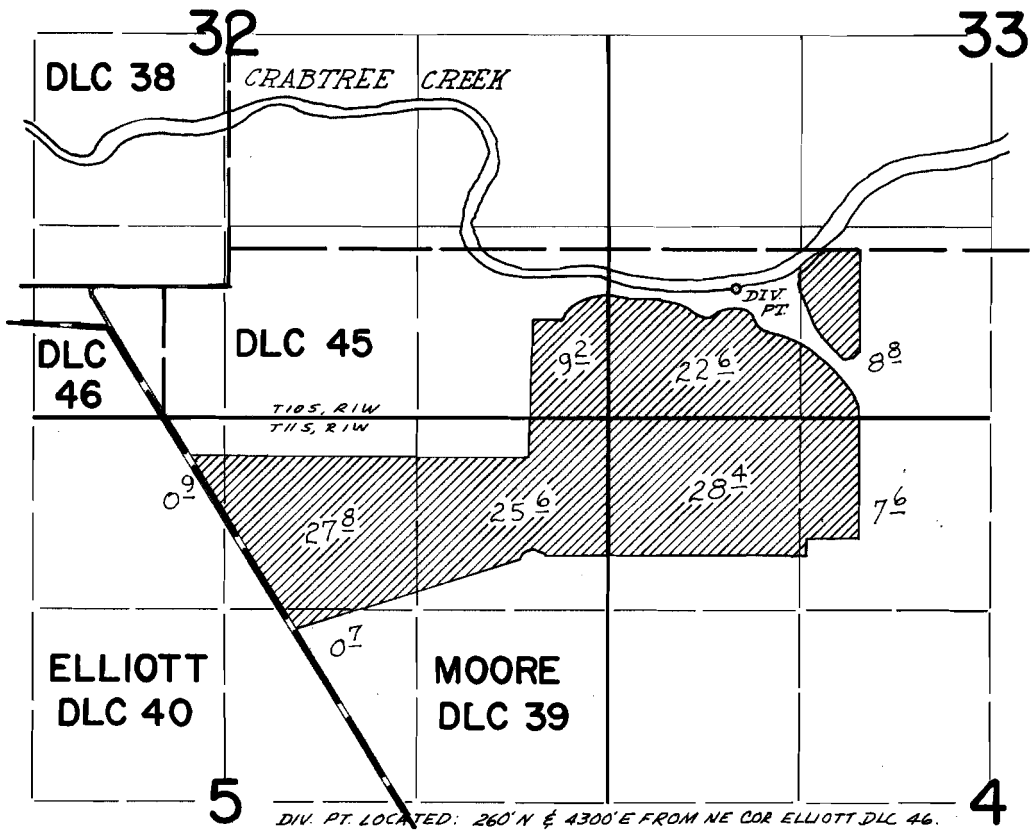

FINAL PROOF SURVEY UNDER

Application No. 44091 Permit No. 32940
IN NAME OF

CHARLES CROSS

Surveyed May 21 1974, by D. Norby