


T. IOS., R. I.W., W.M.

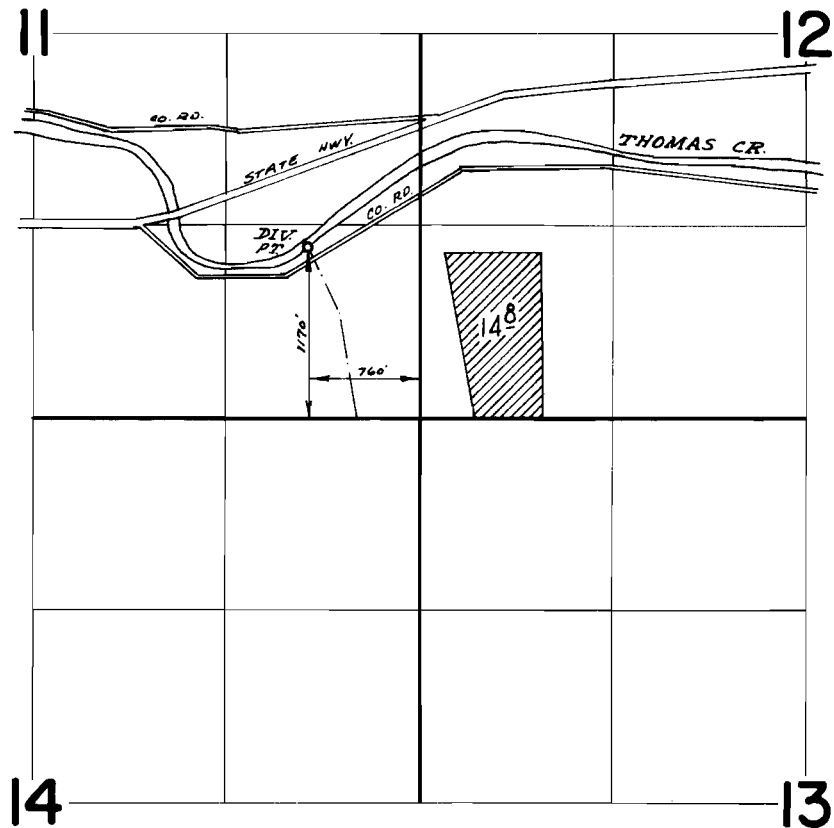

FINAL PROOF SURVEY UNDER

Application No. 47947 Permit No. 35686
IN NAME OF

GENE AND MELBA HALSEY

Surveyed Oct. 16 1974, by D. Norby