


T. 4 S., R. 10 W., W.M.

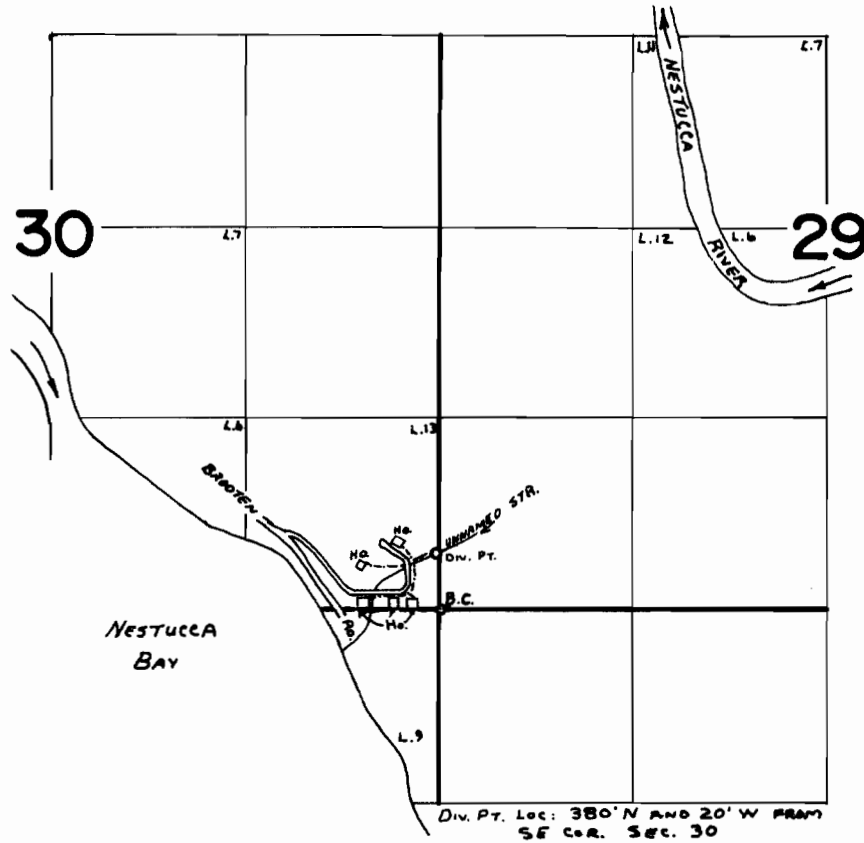

FINAL PROOF SURVEY
UNDER

Application No. **39267**.... Permit No. **29248**....
IN NAME OF

JESS CONNOR & MARION C. SUTTON

Surveyed **Aug. 27, 1974**, by **L. T. Tolb**.....