


T. 4S. R. 1W. W.M.

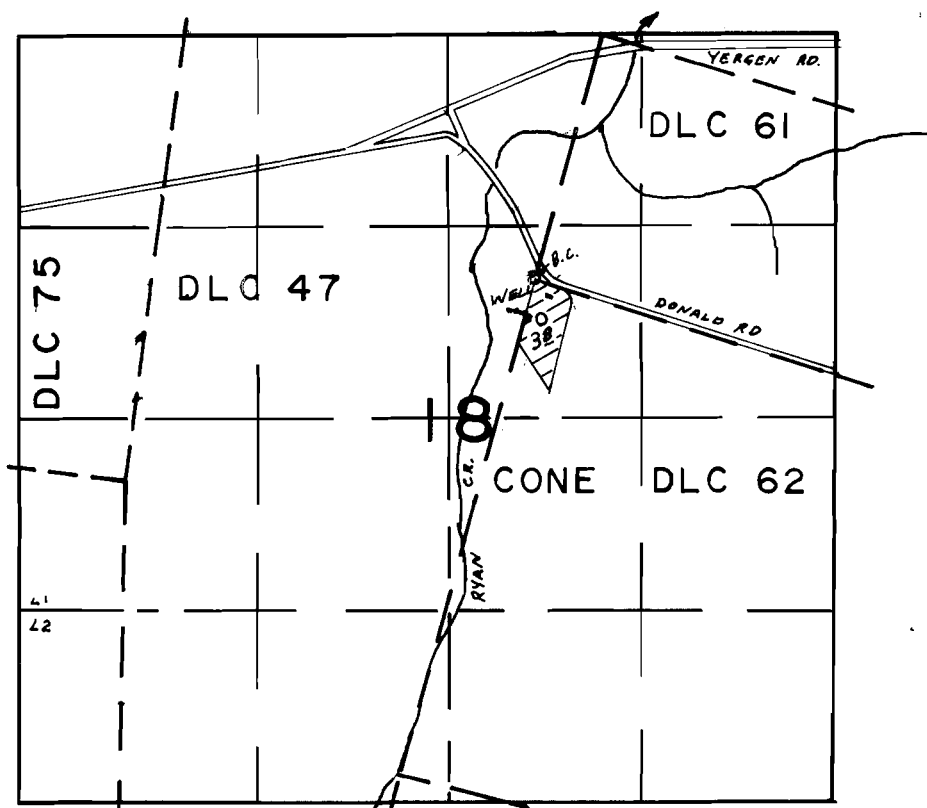

WELL LOC. 270'S & 30'E FROM NW COR. OF CONE DLC 62

FINAL PROOF SURVEY UNDER

Application No. G-5236 Permit No. G-5093
IN NAME OF

EDWIN KLUNDT

Surveyed MAY 23, 1974, by L.H. NUNN