


T.6S., R.3&4W., W.M.

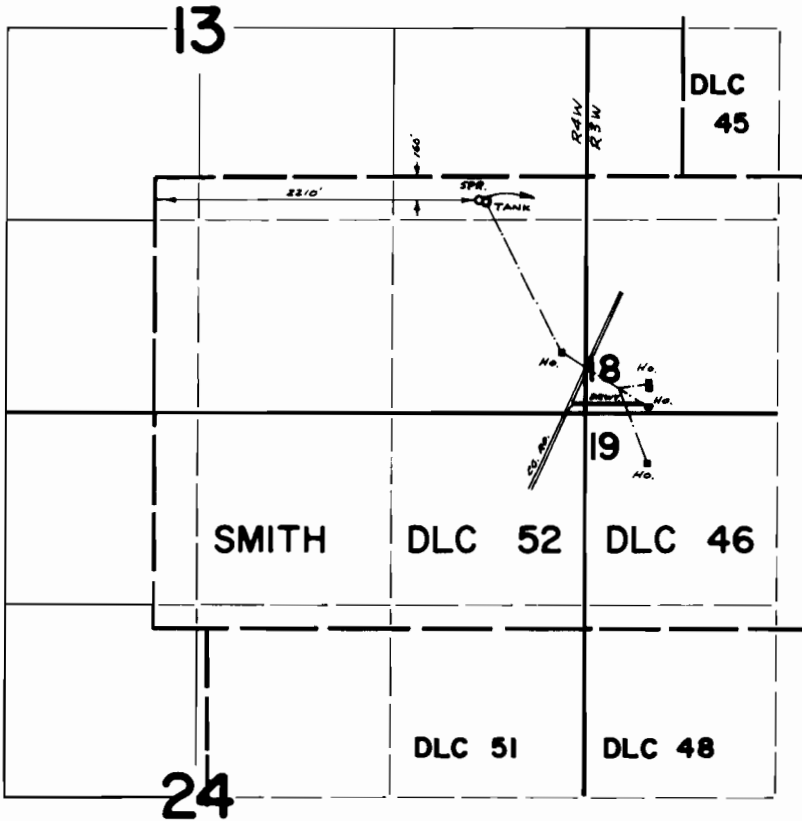

FINAL PROOF SURVEY
UNDER

Application No. 46636 Permit No. 34847
IN NAME OF

N. ERNEST GRESHAM

Surveyed June 10 1975, by L.H. Nunn
June 11 1975 D. Norby