


# T. 4 S., R. 10 W., W.M.

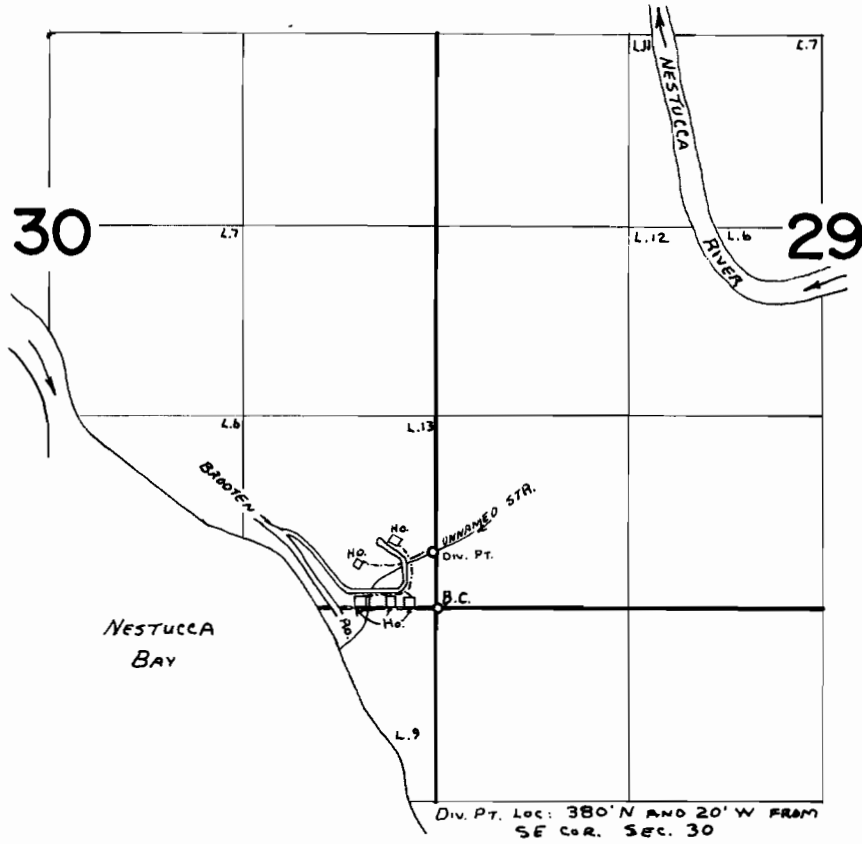

## FINAL PROOF SURVEY UNDER

Application No. 39267 Permit No. 29248  
IN NAME OF

JESS CONNOR & MARION C. SUTTON

Surveyed Aug. 27, 1974, by L. TOLL