


T.1N.,R.9W.,W.M.

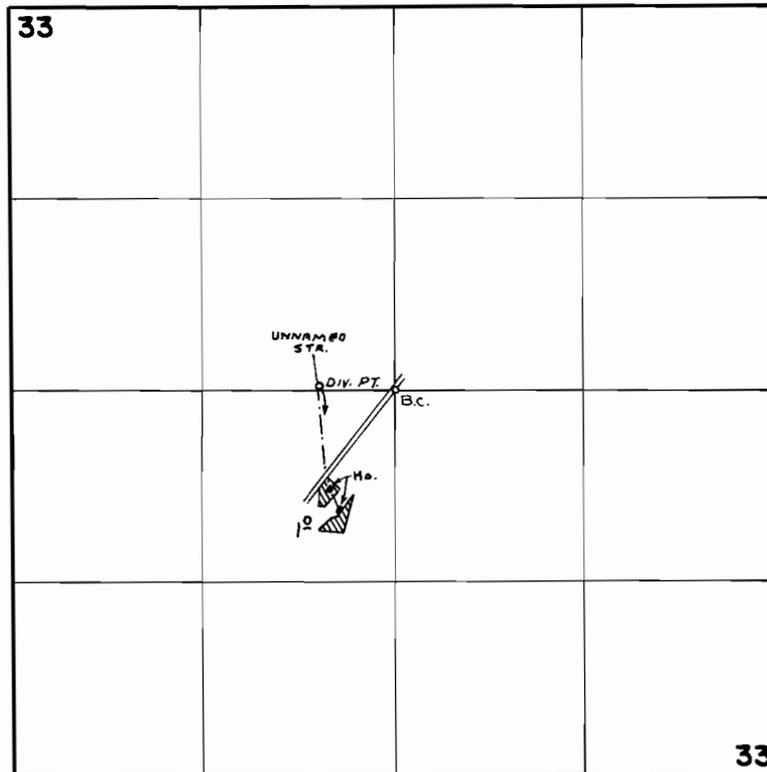

Div. Pt. Loc. - 20' N AND 530' W FROM C/4 SEC. 33

**FINAL PROOF SURVEY**  
UNDER

Application No. **47517** Permit No. **35609**  
IN NAME OF

**M. F. MCLELLAN**

Surveyed **JUNE 26 1974**, by **D. NORBY**