


FINAL PROOF SURVEY
UNDER

Application No. R-41569 Permit No. R-4627
IN NAME OF

DON PEARSON

Surveyed Oct 11 1974, by R.G. MUCKER

T18&2S. R.3W. W.M.

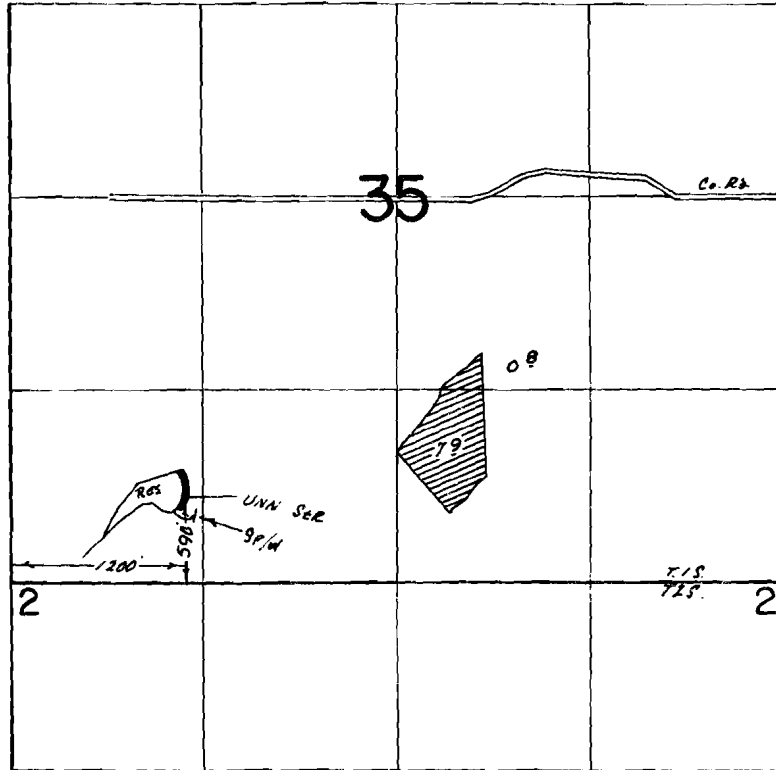

FINAL PROOF SURVEY
UNDER

R-41569 R-4627
Application No.41603 Permit No.30704

IN NAME OF
ESTATE OF
DON PEARSON

Surveyed Oct. 11. 1974, by R. G. MUCKEN