


T18&2S. R.3W. W.M.

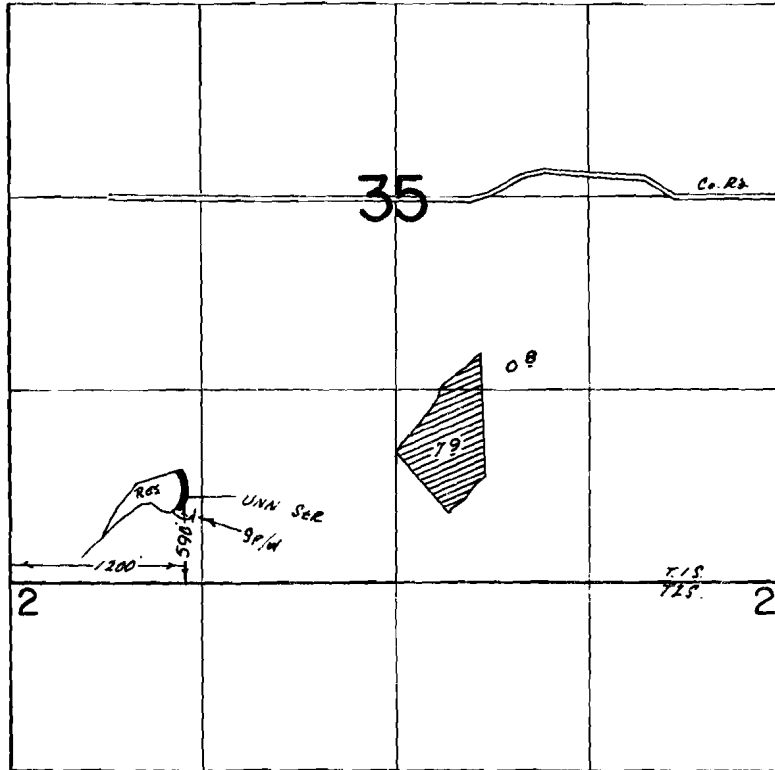

**FINAL PROOF SURVEY**  
UNDER

R-41569 R-4627  
Application No. ....41603 Permit No. ....30704

IN NAME OF  
ESTATE OF  
DON PEARSON

Surveyed Oct...11... 1974, by R...G...MUCKEN