


T.1S. R.2W. W.M.

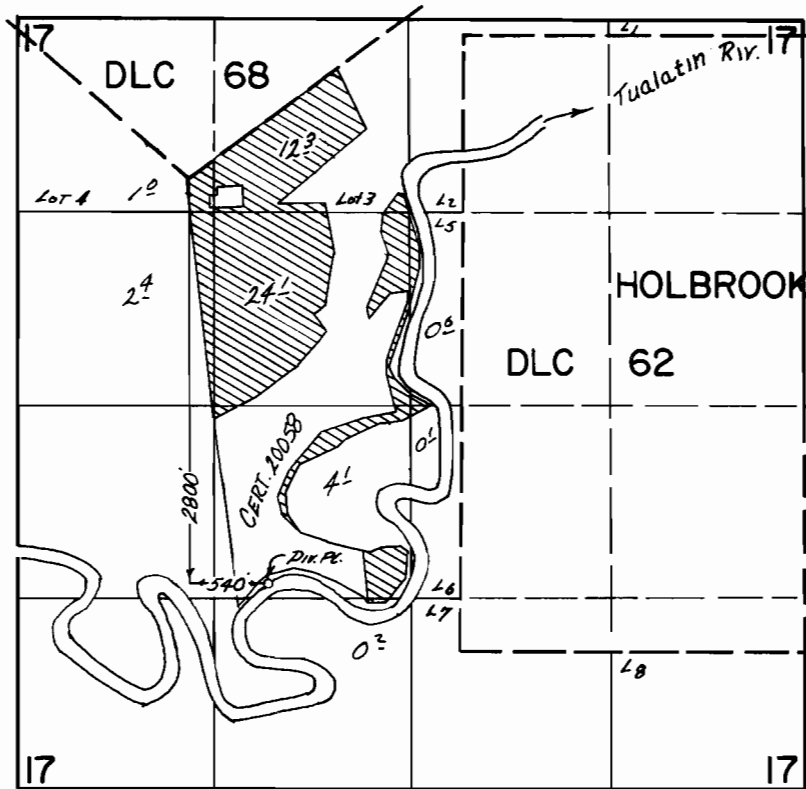

**FINAL PROOF SURVEY**  
UNDER

Application No. 41211..... Permit No. 30814...  
IN NAME OF

HENRY VAN DOMELLEN

Surveyed July 23, 1974, by R. G. MUCKEN