


T.3S. R.1W. W.M.

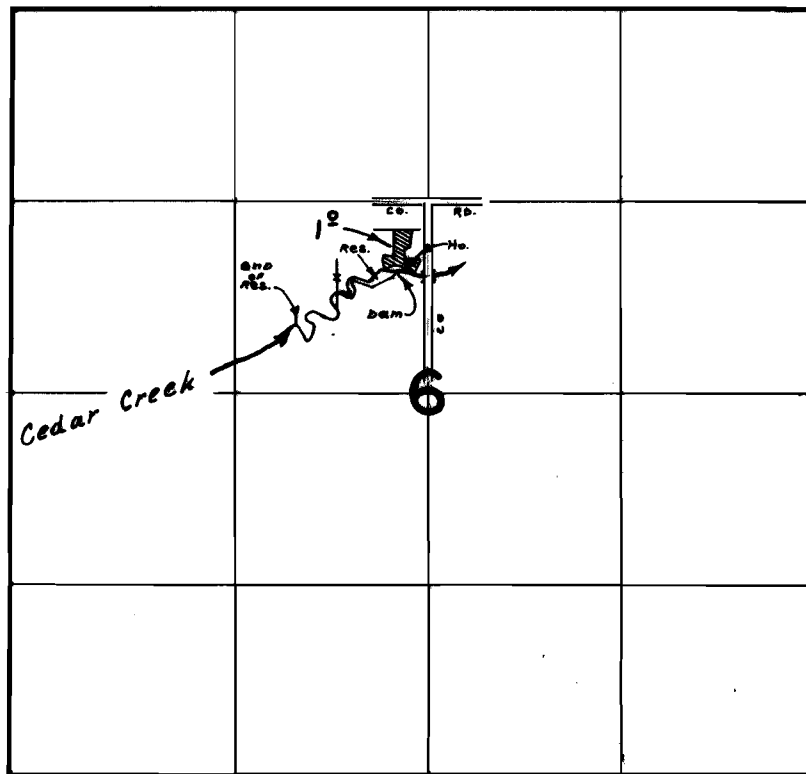

DAM LOC: 180' S. AND 120' W. FROM NE. COR. SE 1/4 NW 1/4 SEC. 6

FINAL PROOF SURVEY
UNDER

R-42591 R-4721
Application No. 42592 Permit No. 31228
IN NAME OF

OTTO E. ARNDT

Surveyed May 16, 1975, by R. Mueken