


T. 1N. R. 3W. W.M.

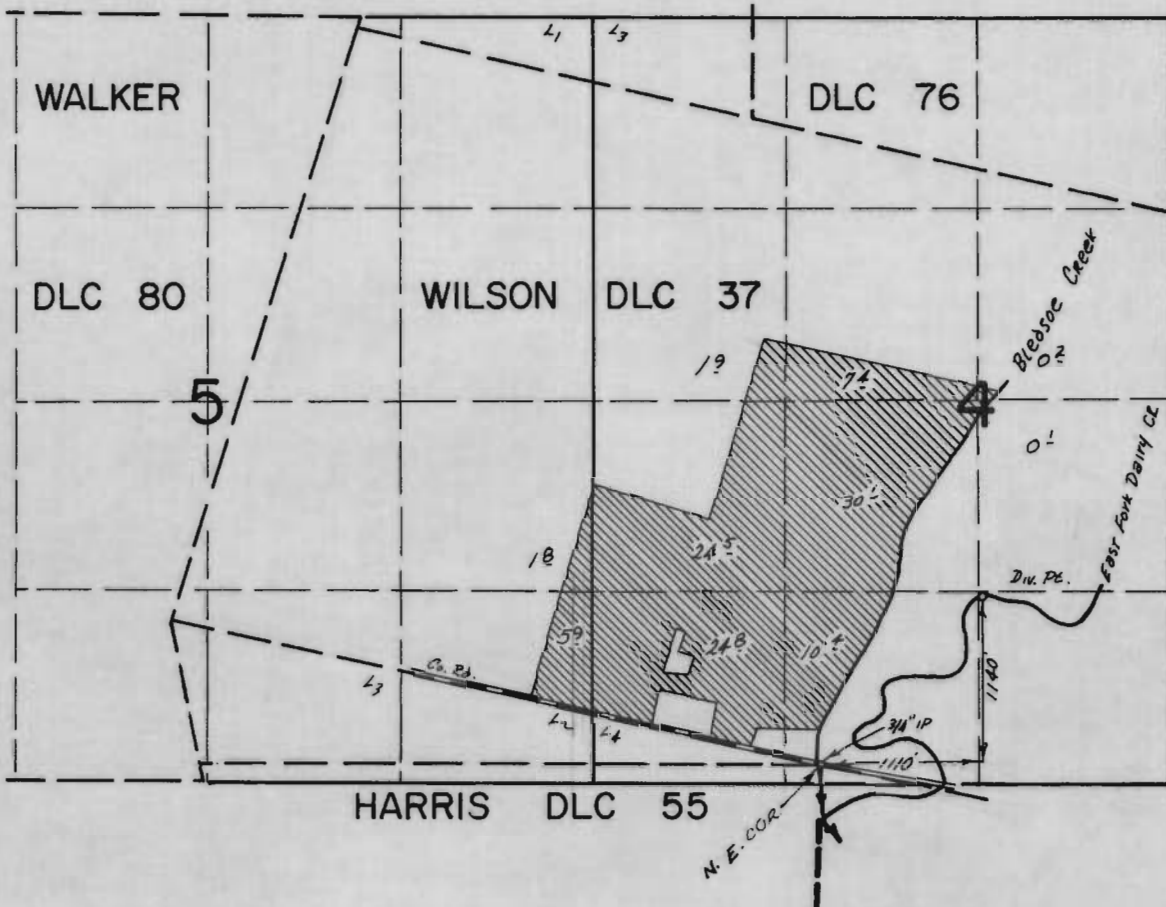

FINAL PROOF SURVEY
UNDER

Application No. 48098... Permit No. 36121...
IN NAME OF

JOSEPH DUYCK

Surveyed April 4, 1974, by R. G. MUCKEN