


T.2S. R.2W. W.M.

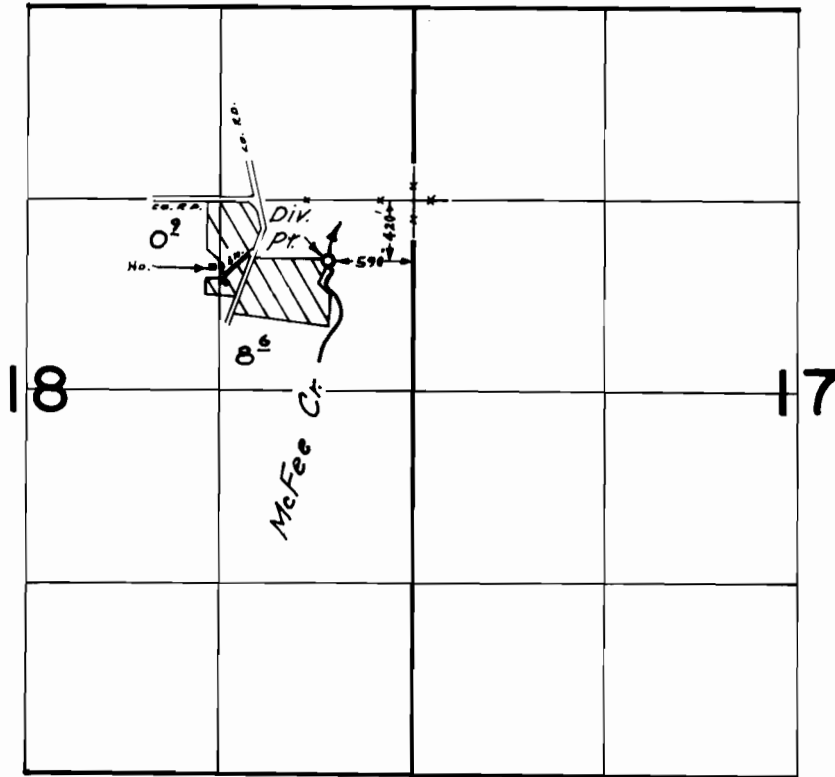

FINAL PROOF SURVEY
UNDER

Application No. 49776 Permit No. 36246
IN NAME OF

RODNEY P. COLTON

Surveyed May 14, 1975, by R. Mucken