


T.3N. R.3W. W.M.

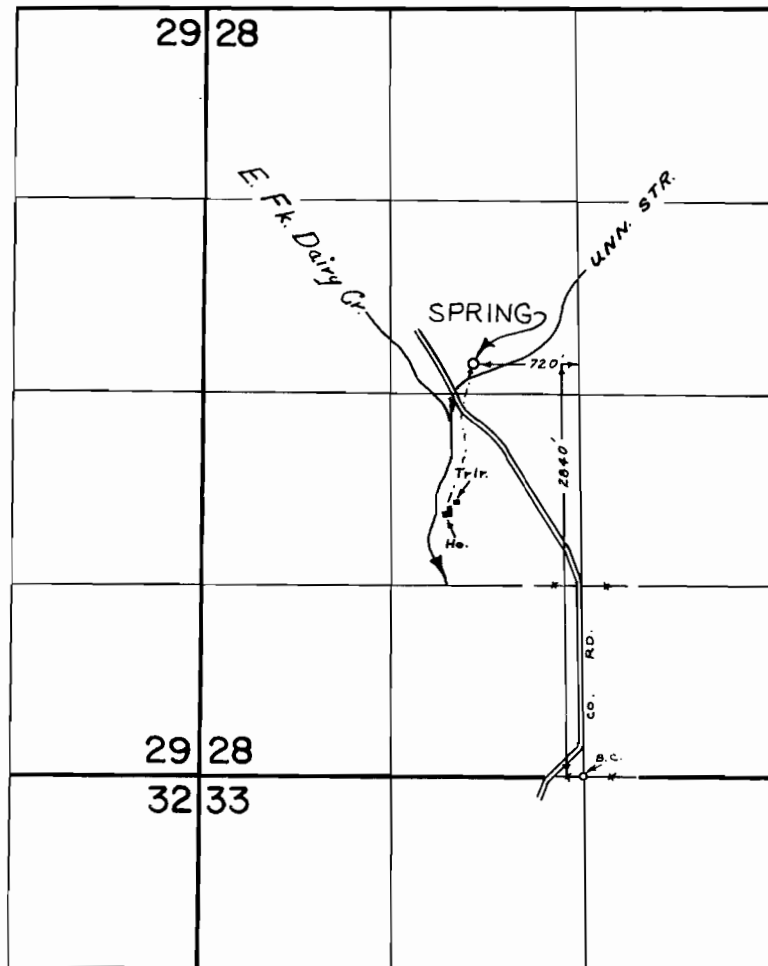

FINAL PROOF SURVEY
UNDER

Application No. 48645 Permit No. 36488
IN NAME OF

GORDON STANLEY LEWIS

Surveyed Sept. 11, 1975, by R. Mucken