


T.28&3S. R.2W. W.M.

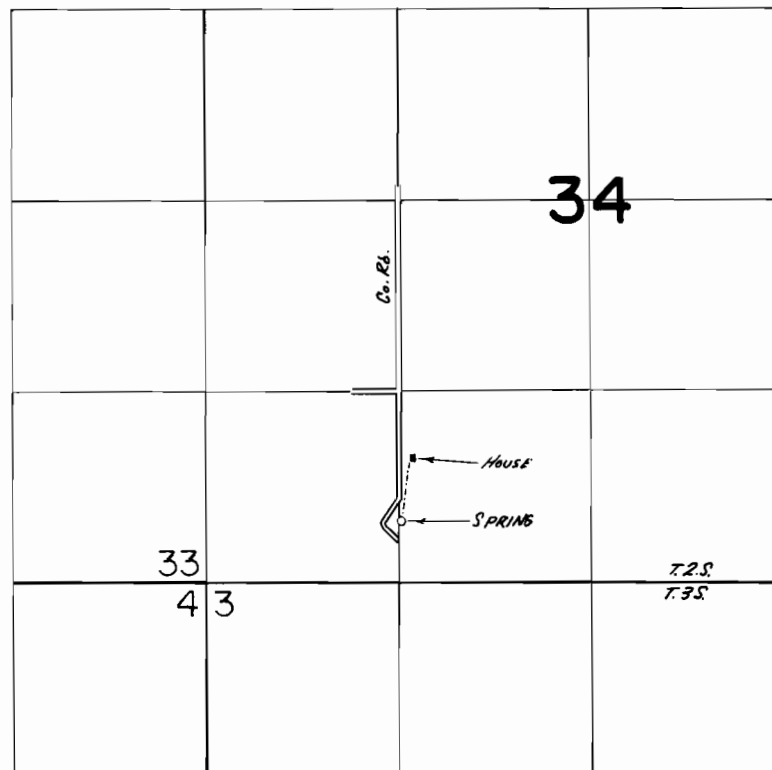

SPRING LOC 900'S & 10'E FROM NW CoR SE 1/4 SW 1/4 SEC 34

FINAL PROOF SURVEY
UNDER

Application No. 49051... Permit No. 36750...
IN NAME OF

KENT J. DUTSON

Surveyed May 15, 1974, by R. G. MUCKEN