


T.3N.R.5W.W.M.

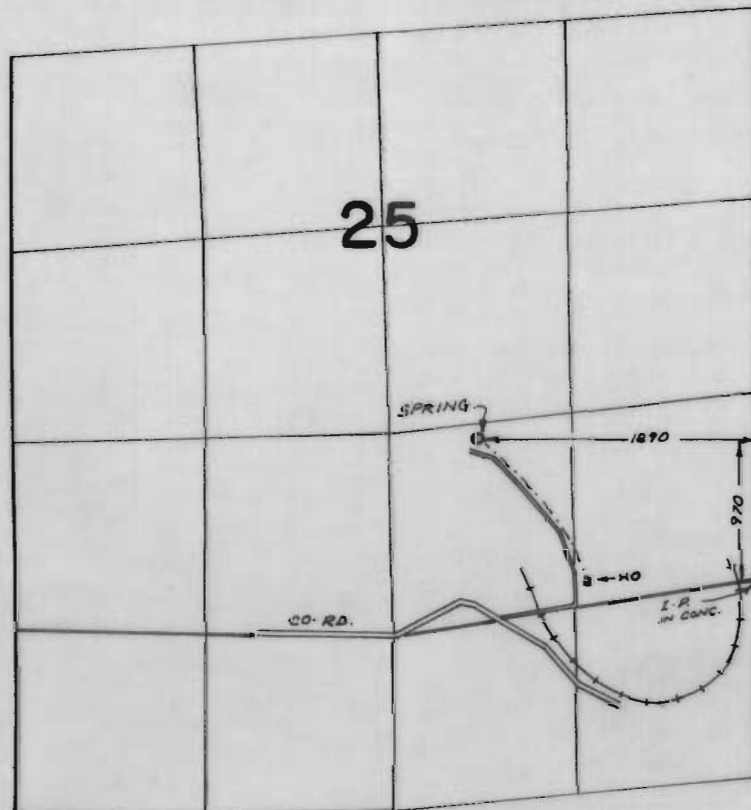

FINAL PROOF SURVEY
UNDER

Application No. 49410 Permit No. 37026
IN NAME OF

FRIEDA ROSE STRASEL

Surveyed APR. 4, 1974, by R. MUCKEN