


T.4N.R.27E.W.M.

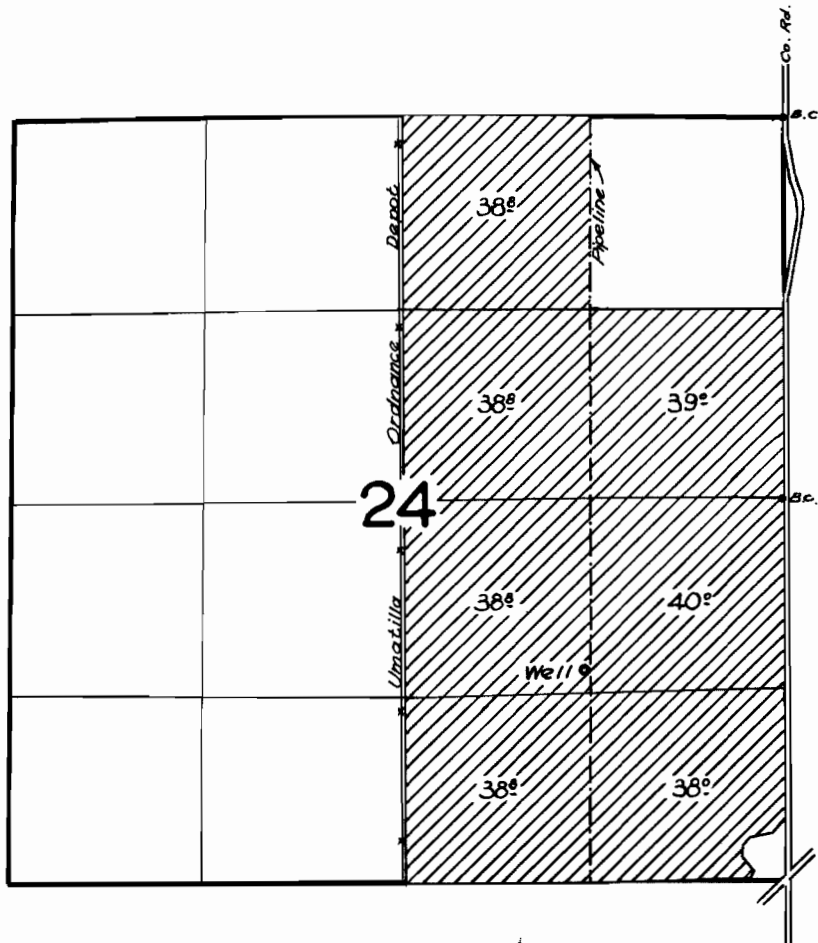

FINAL PROOF SURVEY
UNDER

Application No. **6-111** Permit No. **6-73**
IN NAME OF

CHARLES R. JACKSON

Surveyed June 12 & 13 1962, by *Ch. Jackson*