


T.14S., R.5W., W.M.

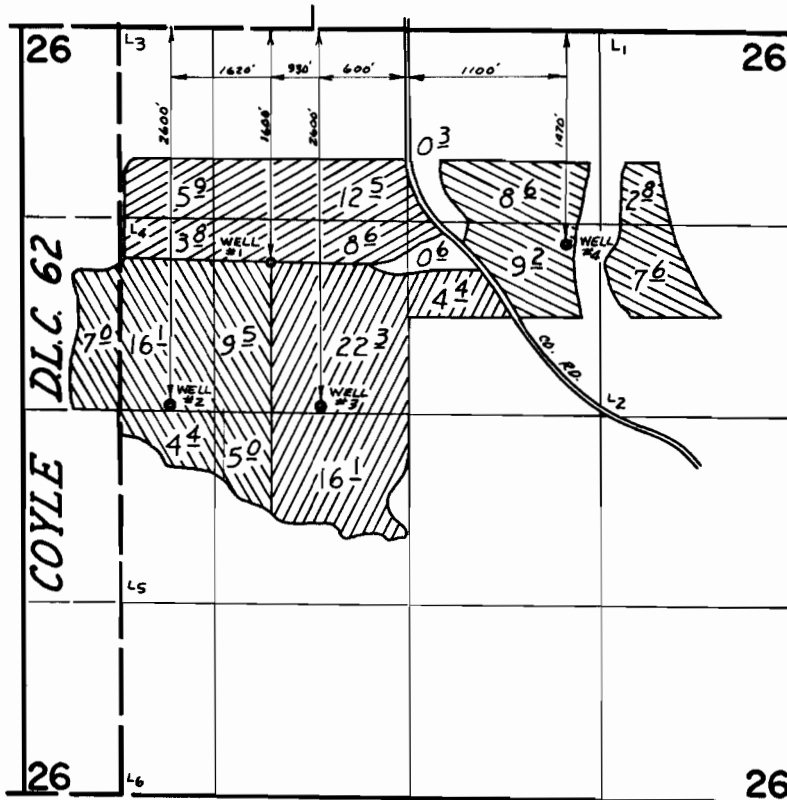

-  WELL #1
-  WELL #2
-  WELL #3
-  WELL #4

FINAL PROOF SURVEY UNDER

Application No. G-4078 Permit No. G-3832
IN NAME OF

FRANCIS E. AND RITA E. GALLAGHER

Surveyed APRIL 25 1973, by D. NORBY