


T.4S.R.4E. W.M.

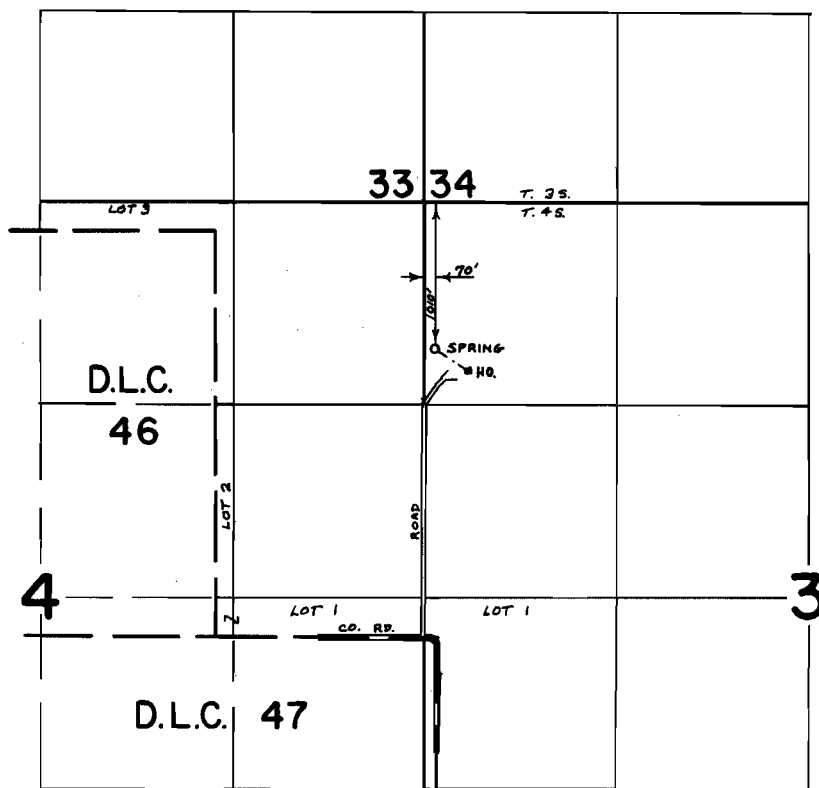

FINAL PROOF SURVEY

UNDER

Application No. 49919 Permit No. 37562.....
IN NAME OF

MILDRED KIGGINS.

Surveyed OCT. 23 1975, by L. TOLL