


T.6N., R.2W., W.M.

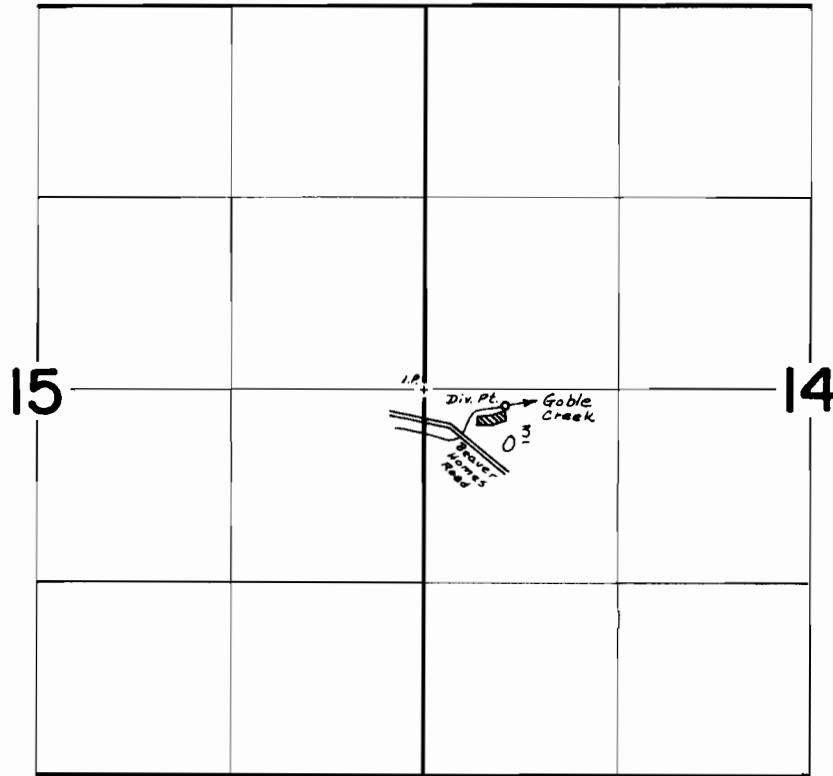

DIV. PT. LOC: 110' S & 550' E FROM W 1/4 COR. SEC. 14.

FINAL PROOF SURVEY
UNDER

Application No. 47930 Permit No. 35904
IN NAME OF

TERRY M. AND DONNA RAE KANDLE

Surveyed Sept. 30 1975, by D. Norby