


T.25S., R.12W., W.M.

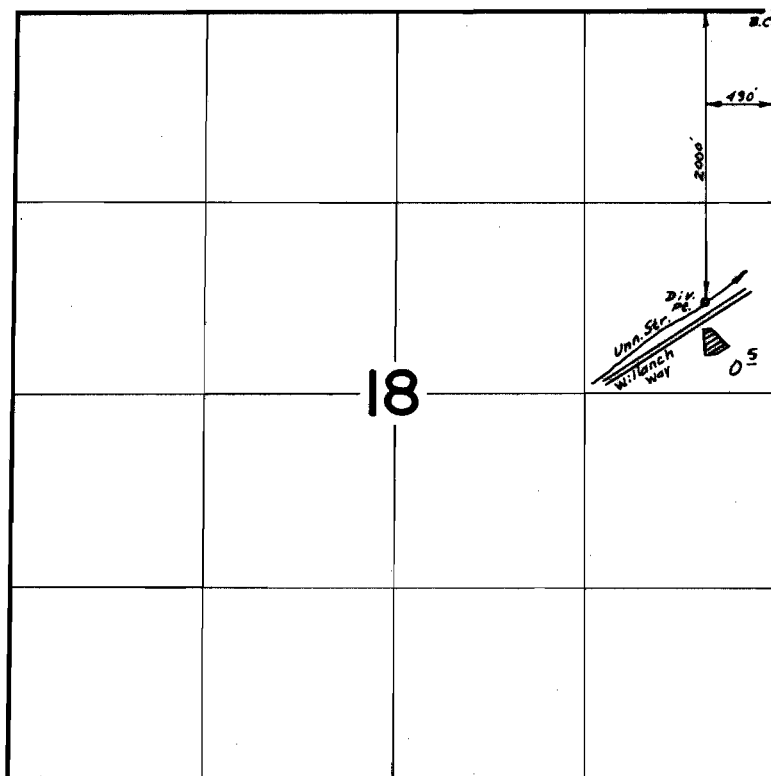

FINAL PROOF SURVEY
UNDER

Application No. 48006 Permit No. 36004
IN NAME OF

HAROLD BETTENCOURT

Surveyed Sept. 19 1975, by D. Norby