


T.23S., R.10W., W.M.

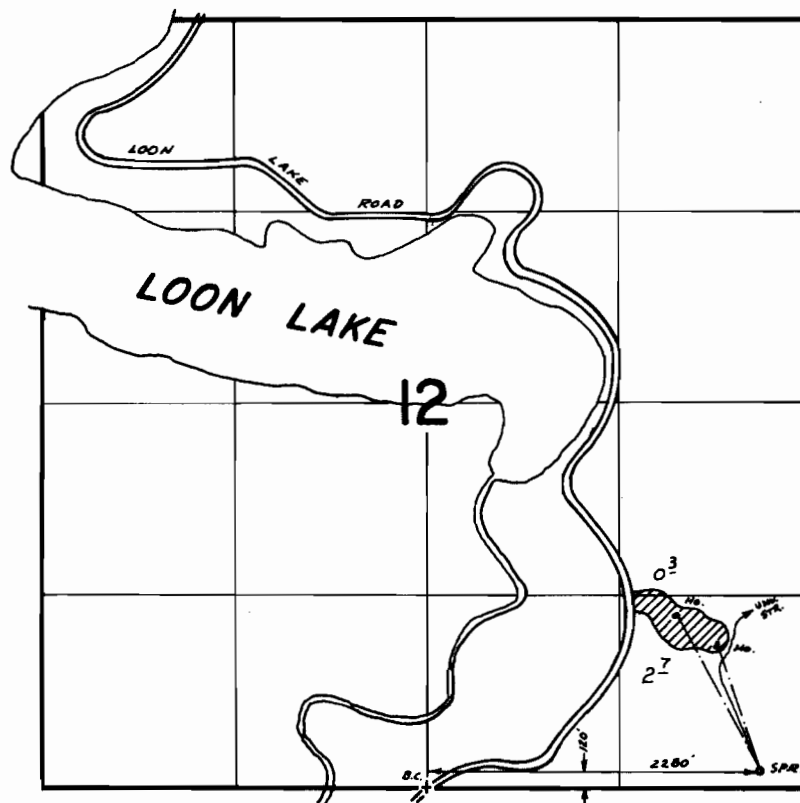

FINAL PROOF SURVEY
UNDER

Application No. 44230 Permit No. 32797
IN NAME OF

PEARL B. BOAK, JACKSON BEAMAN AND IRENE BEAMAN

Surveyed July 23 1975, by D. Norby