


T.30S. R.58&6W. W.M.

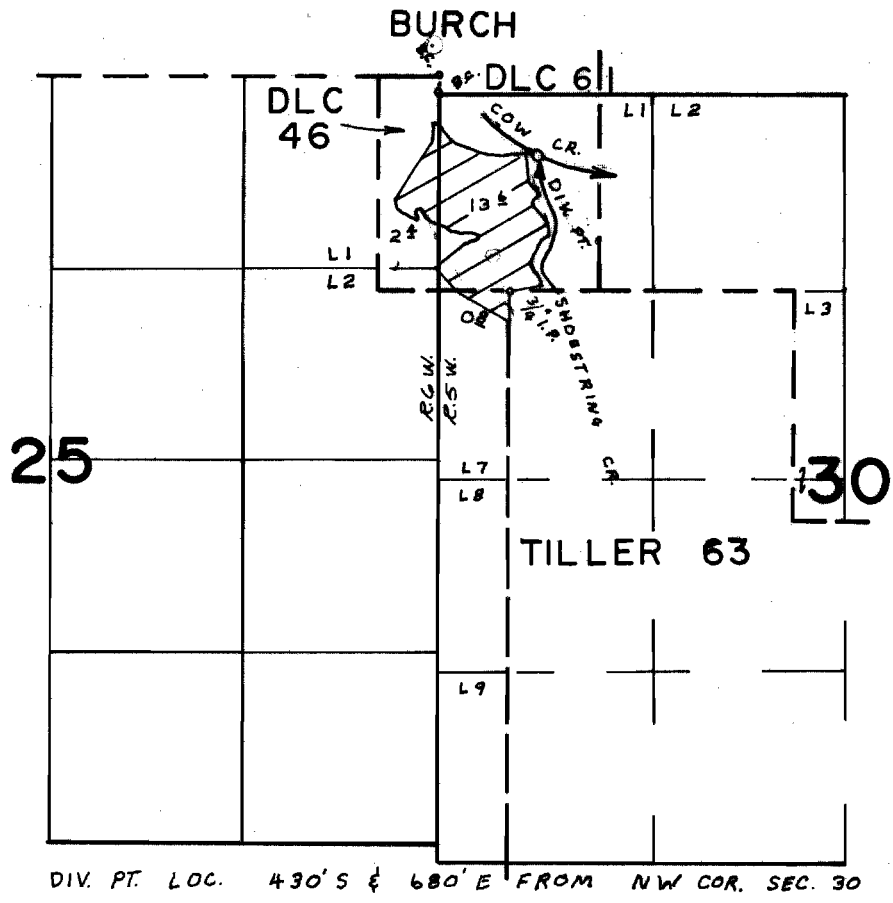

FINAL PROOF SURVEY UNDER

Application No. 47110 Permit No. 35275
IN NAME OF

Benjamin S. Hooley

Surveyed OCT. 22 1975, by LH NUNN