


T.25S. R.6W. W.M.

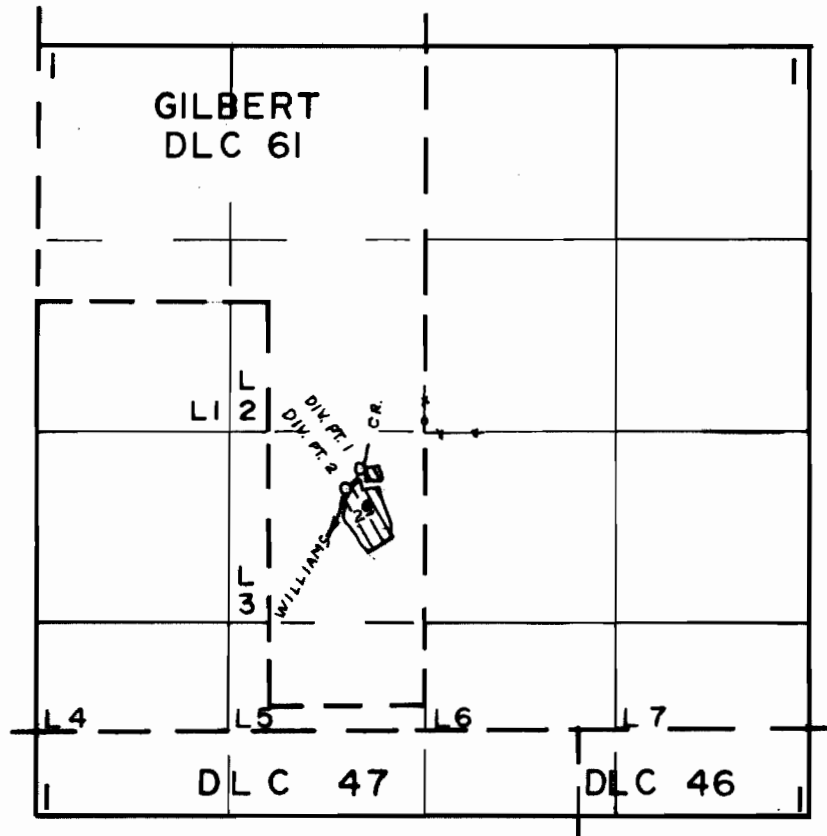

DIV. PT. 1 - 240'S & 430'W., DIV. PT. 2 - 380'S & 520'W, BOTH FROM CENTER SEC. 1.

FINAL PROOF SURVEY UNDER

Application No. 47801 Permit No. 35708
IN NAME OF

RALPH R. & EVA N. McGUFFIE

Surveyed OCT. 2 1975, by LH NUNN