


T. 22 S., R. 8 W., W.M.

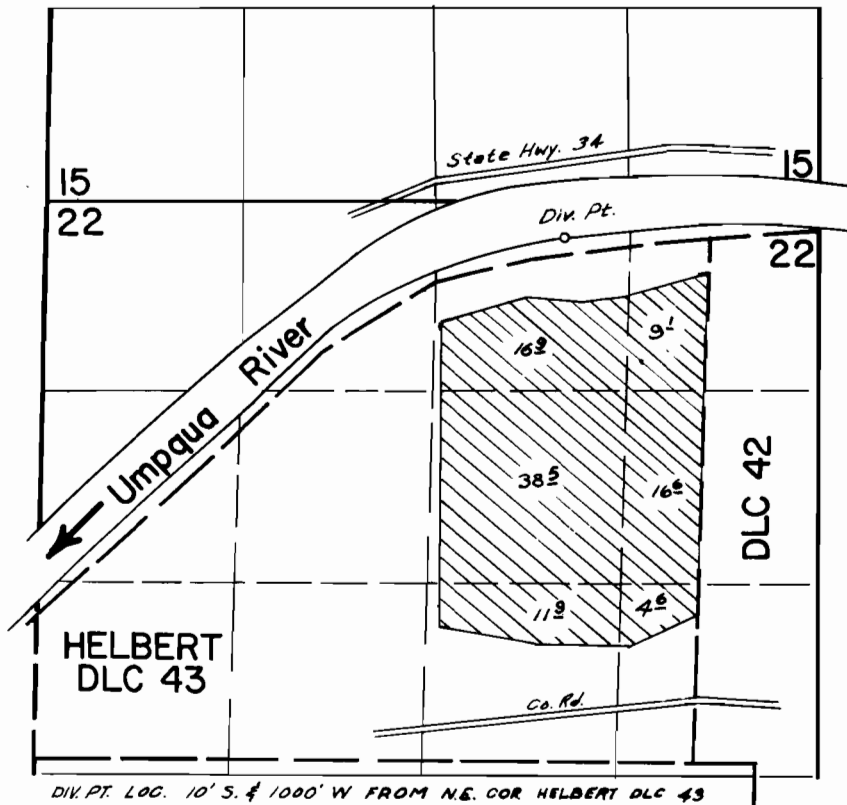

FINAL PROOF SURVEY
UNDER

Application No. 48337 Permit No. 36168
IN NAME OF

DONNA P. WOOLLEY

Surveyed JULY 25 1975, by D. NORBY