


T.30S. R.6W. W.M.

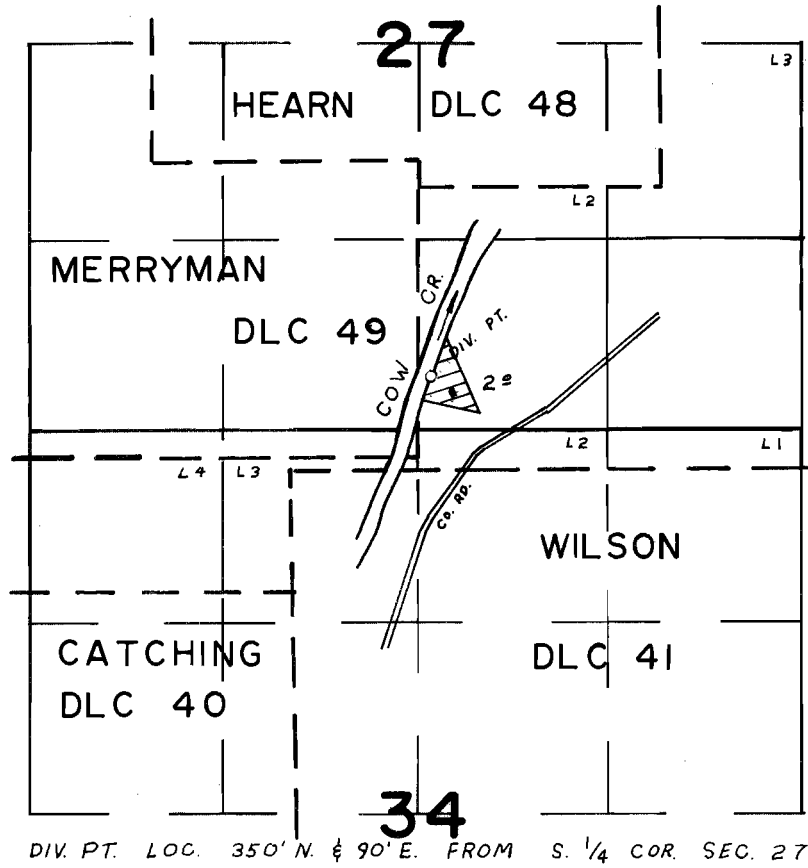

DIV. PT. LOC. 350' N. & 90' E. FROM S. 1/4 COR. SEC. 27

**FINAL PROOF SURVEY**  
UNDER

Application No. 50203... Permit No. 37697...  
IN NAME OF

GERALD L. & KATHRYN I. STINNETT

Surveyed OCT. 21. 1975., by L.H. NUNN