


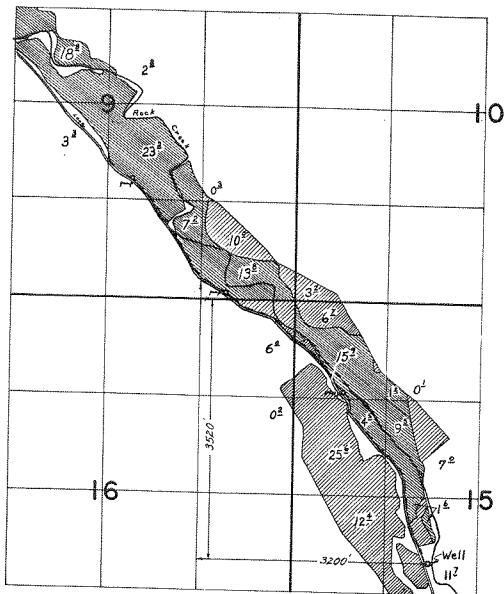

T.2S. R.22E. W.M.

G 3458  
43898



 - Primary  
 - Supplemental

**FINAL PROOF SURVEY**  
UNDER

Application No. G-3713 Permit No. G-3458  
IN NAME OF

LEE AND PATRICIA PETTYJOHN

Surveyed APRIL 4, 1974, by L.E. GOULD