


# T. 38 S. R. 1 W. W. M.

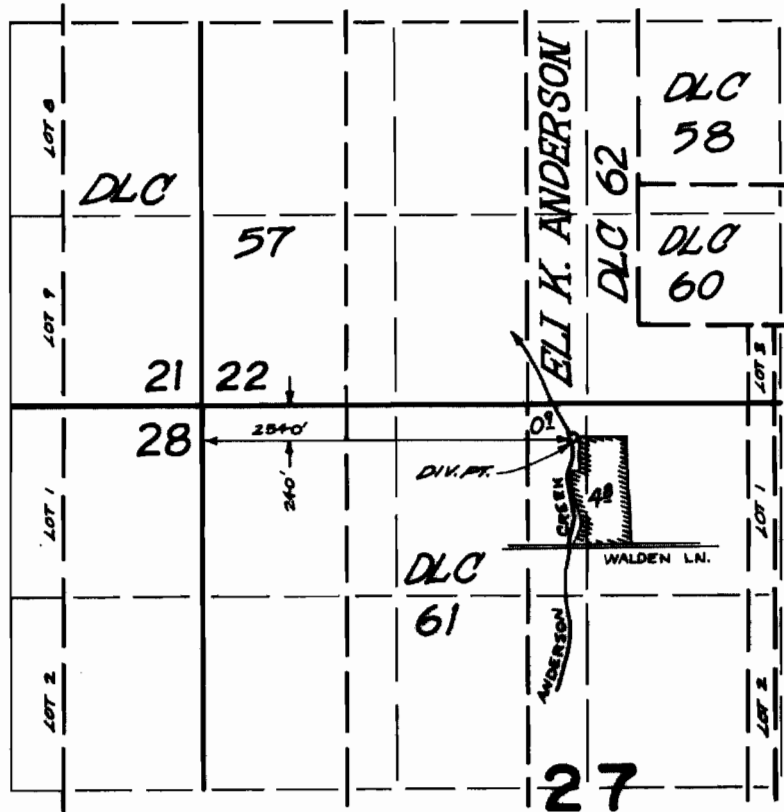

## FINAL PROOF SURVEY UNDER

Application No. 45785 Permit No. 31-214  
IN NAME OF

ASSOCIATED FRUIT CO.

Surveyed JULY 12 1974, by L.M. TOWL