T. 38 S. R. 1 W. W.M.

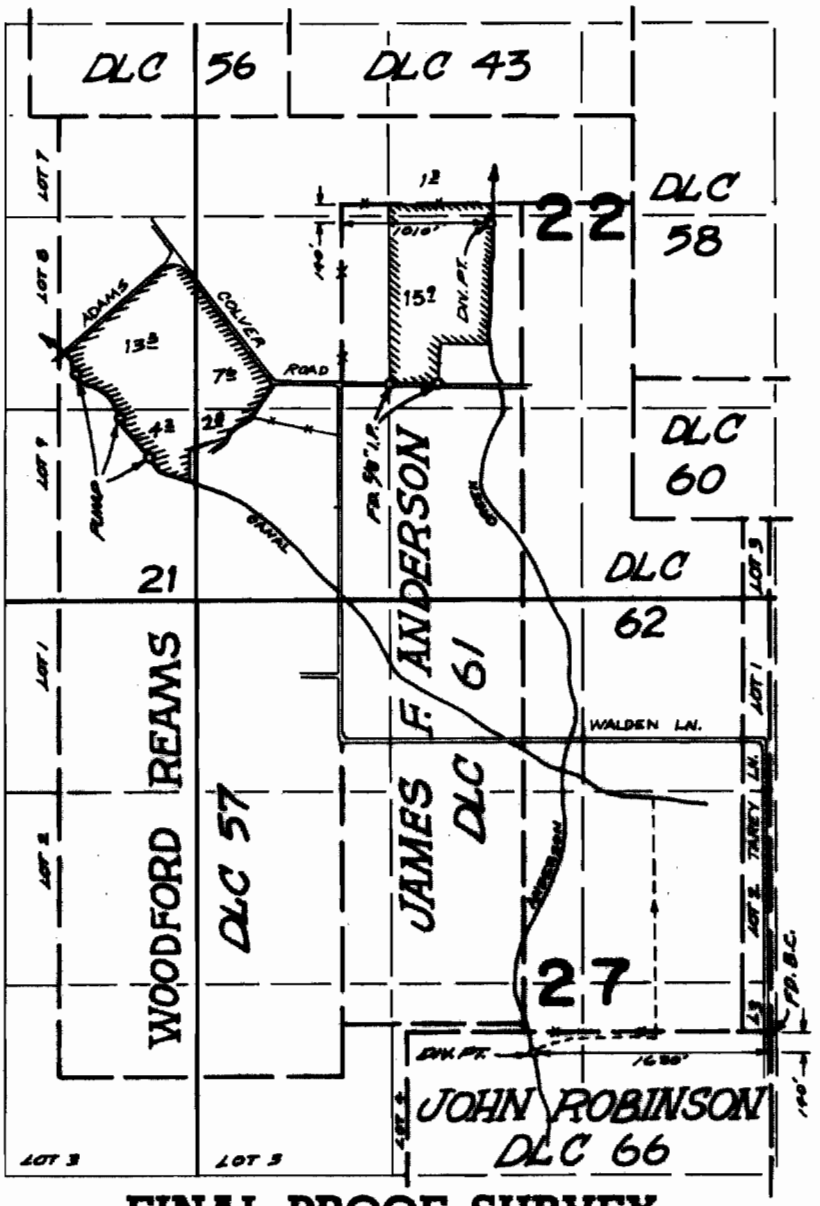

FINAL PROOF SURVEY
UNDER

45784 34213
Application No. 45792 Permit No. 34216
IN NAME OF

DAVID B. and/or MARY L. LOWRY

Surveyed JULY 11-12-19 74, by LiM-TOLL

PTS. 1974 V CRK