


T. 35 S. R. 3 W. W.M.

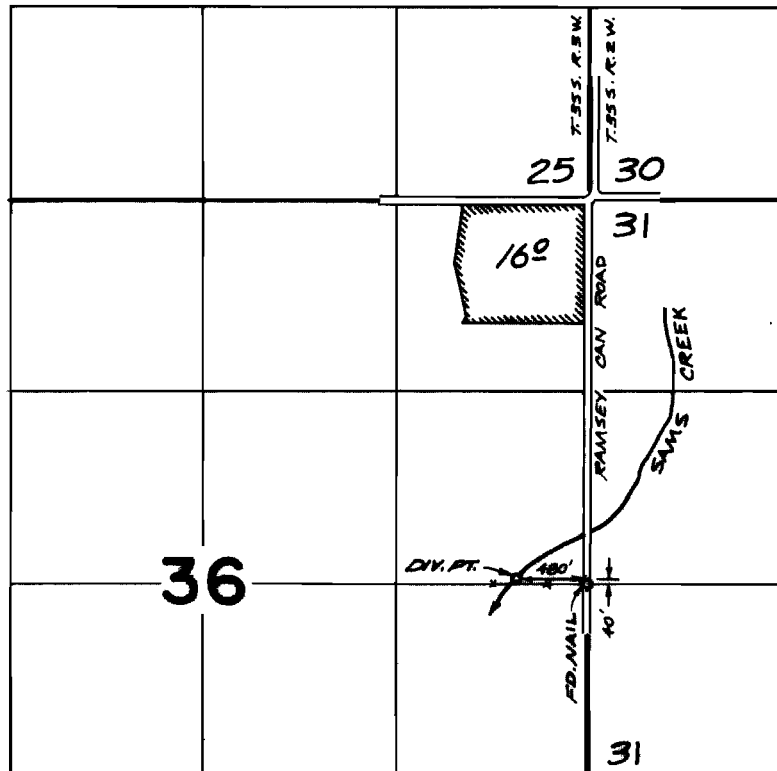

FINAL PROOF SURVEY
UNDER

Application No. 46570 Permit No. 31409
IN NAME OF

ASSOCIATED FRUIT CO.

Surveyed JULY 29, 1974, by D. NORBY