


T.38S. R.2W.W.M.

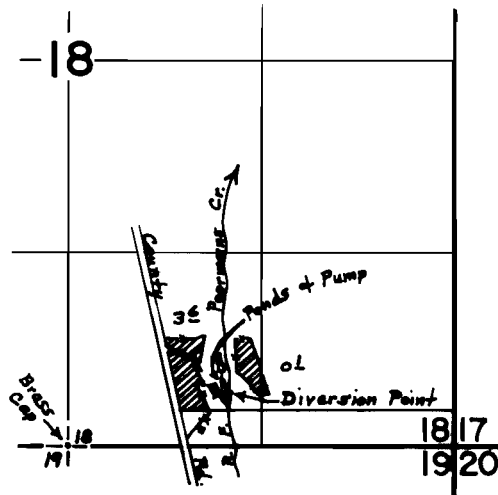

*Diversion Point is located 335' N. & 1110' E.
from S 1/4 Corner of Section 18.*

FINAL PROOF SURVEY
UNDER

Application No. 48638 Permit No. 36484
IN NAME OF

James E. Dunn II

Surveyed April 29 1976, by D. L. Hendrix