


T.35S. R.6W. W.M.

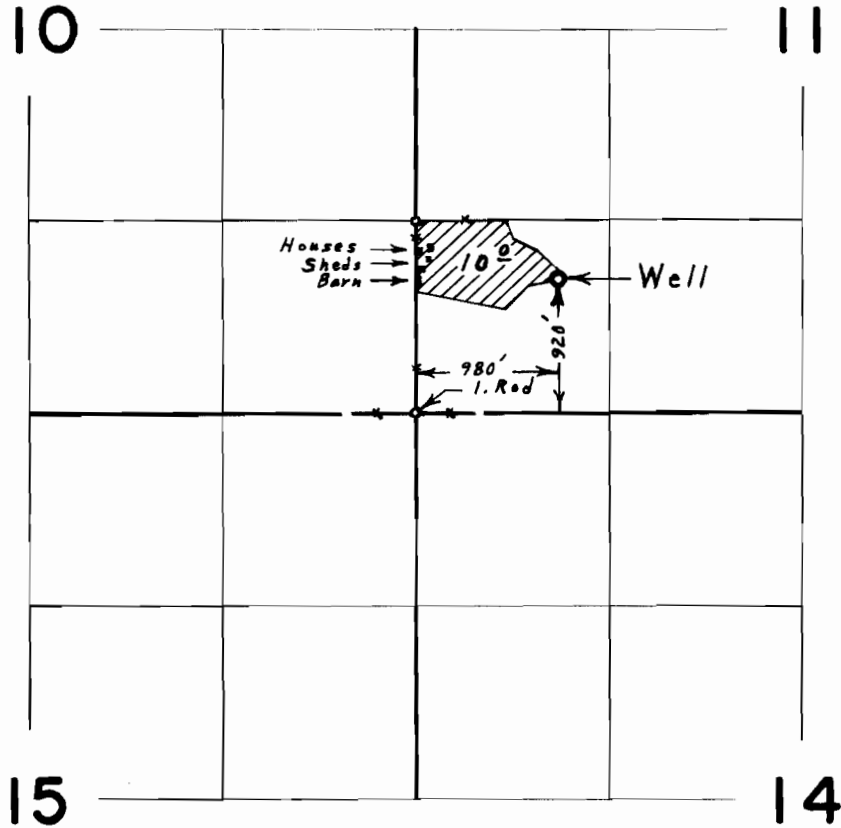

FINAL PROOF SURVEY
UNDER

Application No. G-4846 Permit No. G-4577
IN NAME OF

RICHARD A. PURSELL

Surveyed April 17, 1974, by L. E. Gould