


T.38S.,R.5W.,W.M.

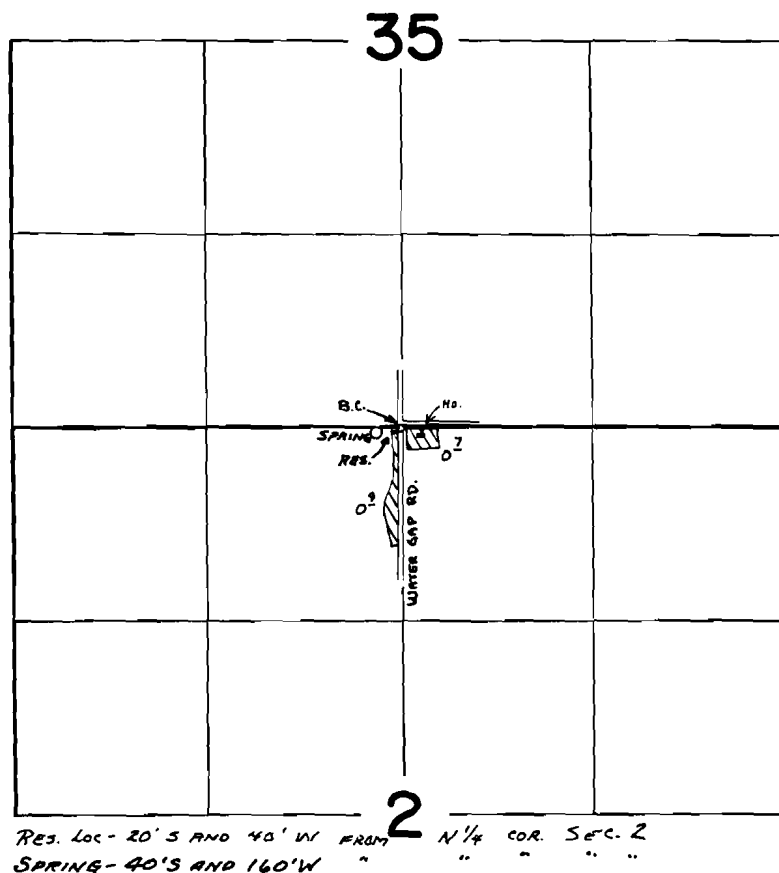

FINAL PROOF SURVEY
UNDER

Application No. R-46376 Permit No. R-5520
IN NAME OF

JOHN R. WOOD

Surveyed SEPT. 18 1974, by L. TOLL