


T.38S.,R.5W.,W.M.

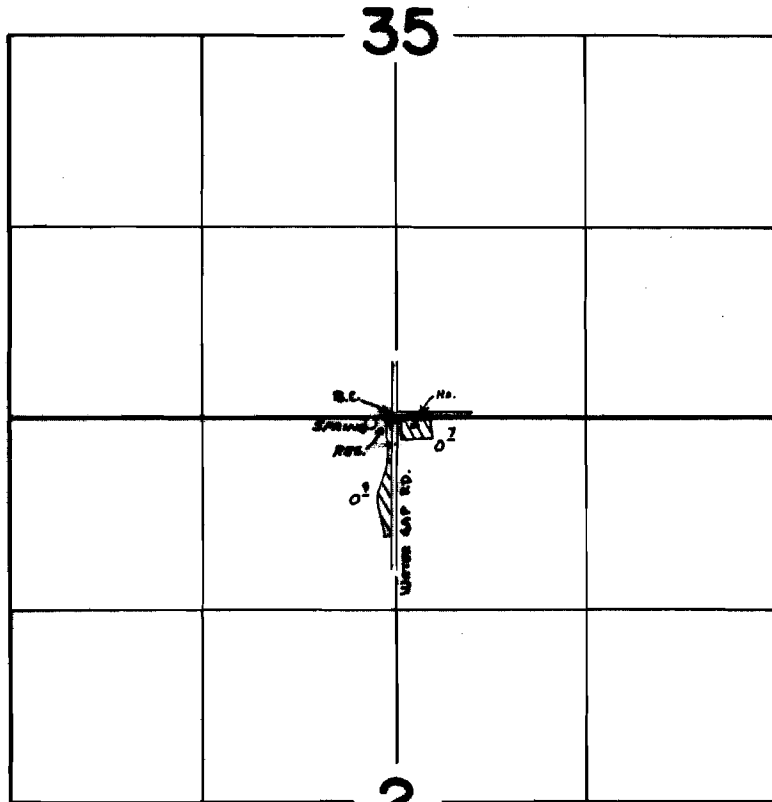

Res. Loc - 20' S AND 40' W FROM N 1/4 COR. SEC. 2
SPRING - 40' S AND 160' W " " " " "

FINAL PROOF SURVEY
UNDER

R-46376 R-5520
Application No. 46377 Permit No. 34637
IN NAME OF

JOHN R. WOOD

Surveyed SEPT. 18 1974, by L. TALL