


T.17S. R.8W. W.M.

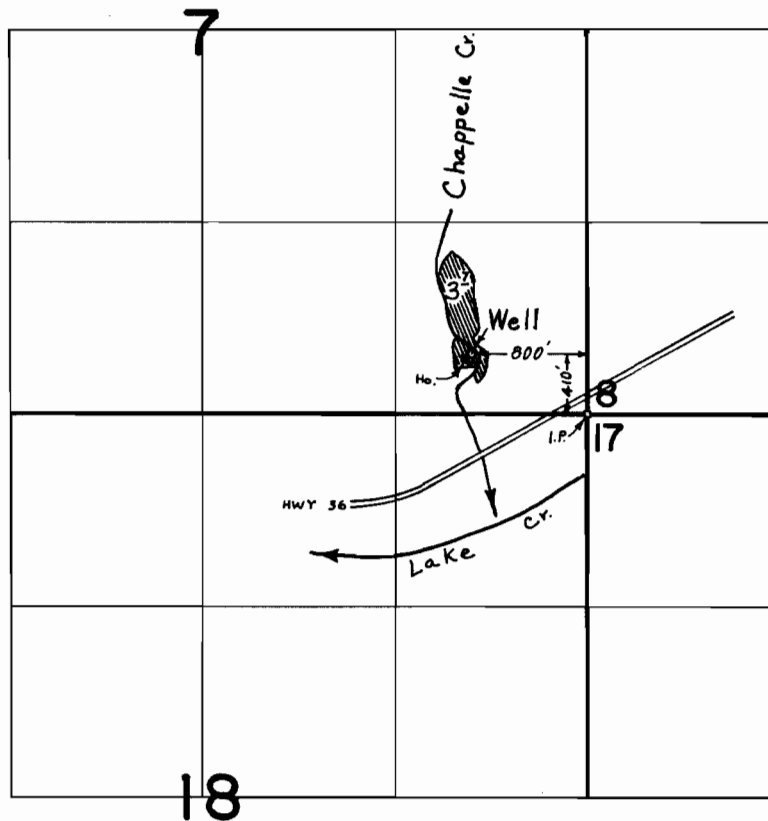

FINAL PROOF SURVEY
UNDER

Application No. G-3208 Permit No. G-3166
IN NAME OF

GEORGE A. UNSER

Surveyed May 9, 1975, by R. Mucken