


T.8S.,R.2W.,W.M.

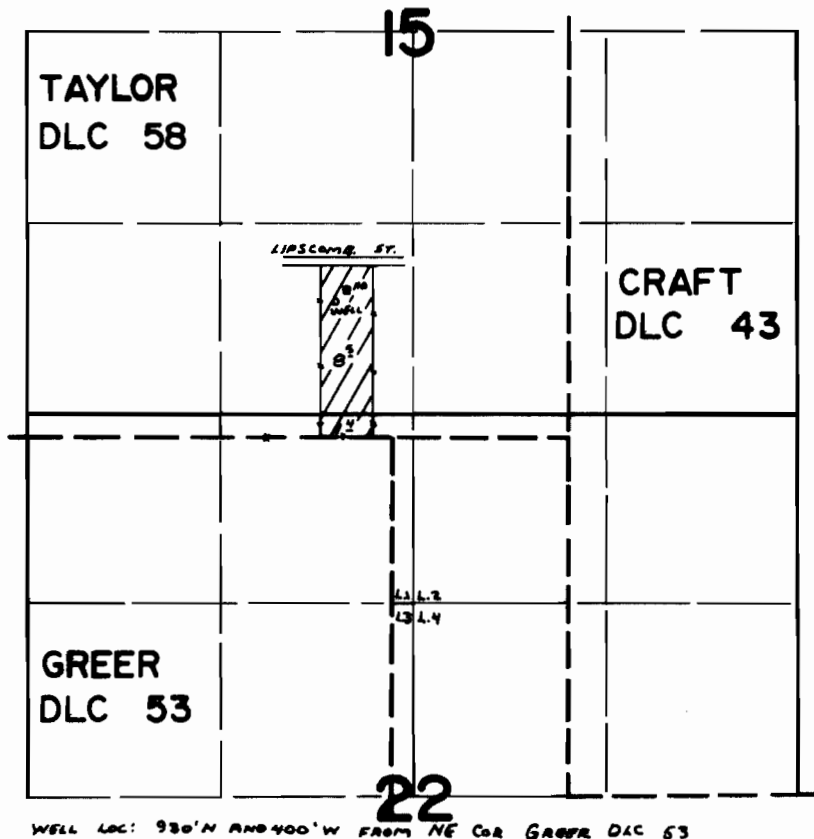

FINAL PROOF SURVEY
UNDER

Application No. G-6111... Permit No. G-5184..
IN NAME OF

JAMES OTTO GRAY

Surveyed SEPT. 2, 1975, by L. Tall