

NW 1/4 NW 1/4 OF NW 1/4  
SEC. 33, T35, R1W

POINT OF DIVERSION  
100'S ± 200' E FROM  
CHLORINATION NW 1/4 - SW 1/4  
SEC. 33

2 1/2" PVC DISCHARGE LINE  
TO WILLAMETTE RIVER  
SEE SHEET NO. 11

2 1/2" DEEP x 17' WIDE  
ASPHALT-PAVED  
OVERFLOW

RESERVOIR #1  
W.S. 155.0 320 ACRES  
DRAINAGE AREA 18 ACRES  
SURFACE AREA 10 ACRES  
IMPOUNDED WATER 70 ACRES-FT.

220'S ± 660' E of NW COR  
of NW 1/4 SW 1/4 of Sec 33

RESERVOIR #2  
W.S. ELEV. 160.0 1.6 ACRES  
SURFACE AREA 4.2 ACRES  
IMPOUNDED WATER 4.2 ACRES-FT.


DAM #2  
CROSS SECTION

NOTE —  
DAM TO BE CONSTRUCTED IN  
STRICT ACCORDANCE WITH PROVISIONS  
OUTLINED IN PERMIT ISSUE OF STATE  
ENGINEER.

Application No. R-48736 & 48737  
Permit No. R-5855 & 36146

RECEIVED  
STATE ENGINEER  
SALEM, OREGON

PLOT PLAN  
1" = 50'

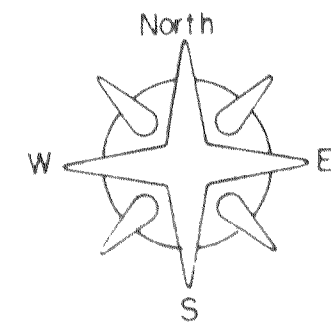

ROADWAY FILL CROSS SEC

HOLDING POND PROFILE  
1" = 10'

REVISED 10-1-71 APP'D D.M. & R.E. #2  
NOTE: OVERFLOW REVISED 3 SEPT.  
F.T.S

NOTE:  
DAM TO BE CONSTRUCTED IN STRICT  
ACCORDANCE WITH PROVISIONS OUT-  
LINED IN PERMIT ISSUE OF STATE ENGR.

Field Copy

|  |   |                  |
|--|---|------------------|
|  | CENTURY MEADOWS NO. 2 & 3 AURORA, OREGON                                                             |                  |
|  | SANITARY SEWER IMPROVEMENTS                                                                          |                  |
|  | CLARK & GROFF ENGINEERS INC.<br>ENGINEERING ARTS BUILDING<br>3276 Commercial, S. E.<br>SALEM, OREGON |                  |
|  | DESIGN CLY                                                                                           | DATE FEB 5, 1971 |

|           |       |
|-----------|-------|
| SHEET     | OF 11 |
| NO. 71135 |       |