


T.7S. R.1E. W.M.

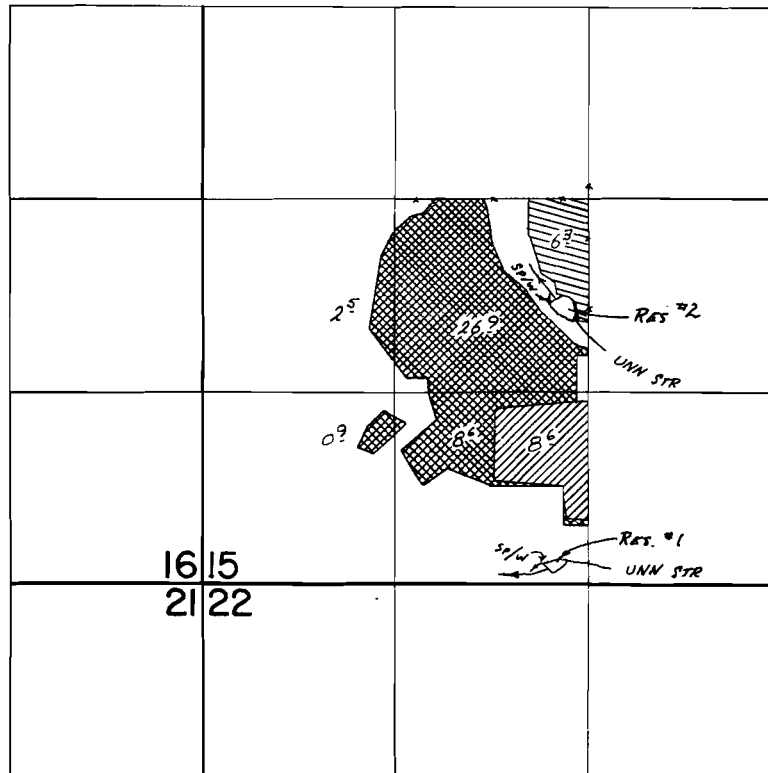

RES. LOC. #2 RES 690'S & 210'W; #1 RES. 2540'S & 280'W
BOTH FROM CENTER SECTION 15.

 S. RES ONLY
 S. RES & UNN STR
 N. RES & UNN STR.

FINAL PROOF SURVEY

UNDER

R-47631

R-5735

47632

35647

R-47633

R-5736

Application No.47634 Permit No.35648

IN NAME OF

.....BONITA E. BRENNEMAN.....

Surveyed April 12, 1974, by T. J. PAUL.....