


T.7S. R.IE.W.M.

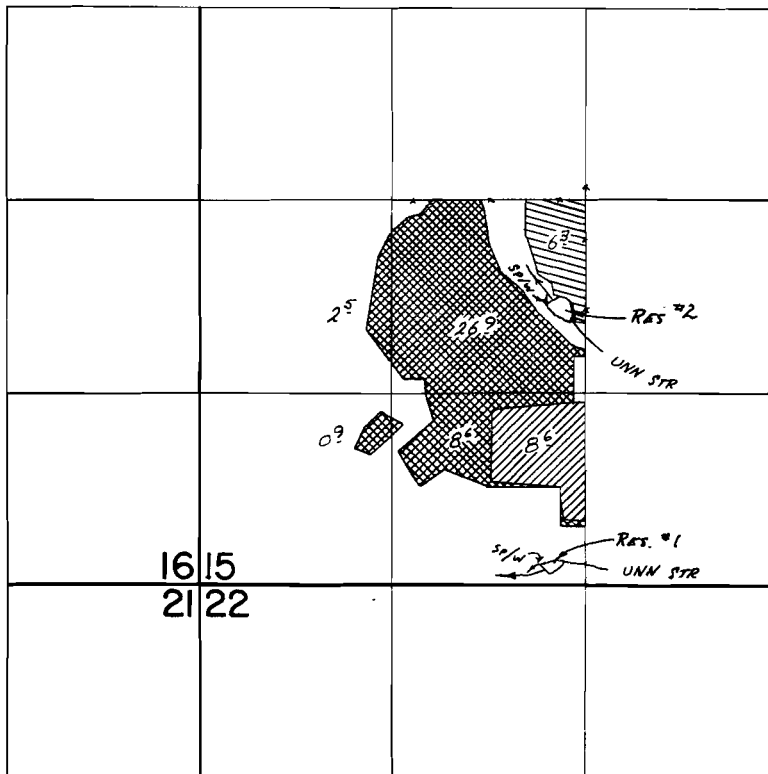

RES. LOC. *2 RES 690'S E 210'W; *1 RES. 2540'S E 280'W
BOTH FROM CENTER SECTION 15.

 S. RES ONLY
 S. RES & UNN STR
 N. RES & UNN STR.

FINAL PROOF SURVEY

UNDER

R-5735

35647

R-5736

Application No. 47634 Permit No. 35648

IN NAME OF

BONITA E. BRENNEMAN

Surveyed April 12, 1974, by T. J. PAUL.....