


T.7S.,R.1E.,W.M.

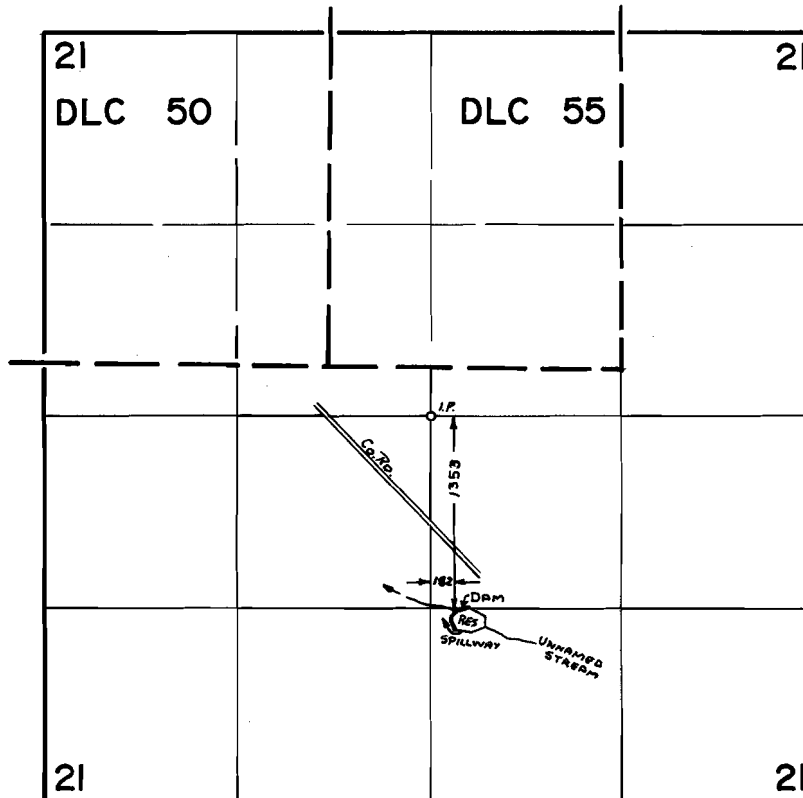

FINAL PROOF SURVEY
UNDER

Application No. **R-47751** **R-5765**
47752 Permit No. **35768**
IN NAME OF

VICTOR J. MEISSNER

Surveyed **SEPT. 4**, 1974, by **L. Toll**