


T.9S.,R.2E.,W.M.

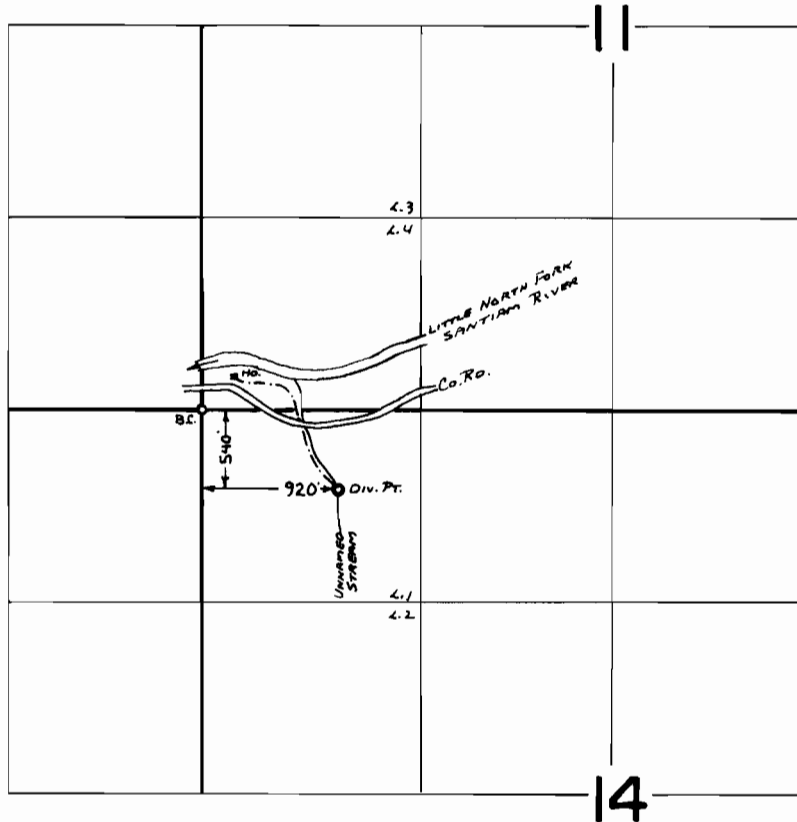

FINAL PROOF SURVEY
UNDER

Application No. 49279 Permit No. 35939
IN NAME OF

ROBERT W. DE ARMOND

Surveyed Aug. 16, 1974, by L. Toht