

NW 1/4 NW 1/4 OF NW 1/4
SEC. 33, T35, R1W

POINT OF DIVERSION
100'S ± 200' E FROM
CHLORINATION NW 1/4 - SW 1/4
SEC. 33

2 1/2" PVC DISCHARGE LINE
TO WILLAMETTE RIVER
SEE SHEET NO. 11

2 1/2" DEEP x 17' WIDE
ASPHALT-PAVED
OVERFLOW

RESERVOIR #1
W.S. 155.0 320 ACRES
DRAINAGE AREA 18 ACRES
SURFACE AREA 10 ACRES
IMPOUNDED WATER 70 ACRES-FT.

220'S ± 660' E of NW COR
of NW 1/4 SW 1/4 of Sec 33

RESERVOIR #2
W.S. ELEV. 160.0 1.6 ACRES
SURFACE AREA 4.2 ACRES
IMPOUNDED WATER 4.2 ACRES-FT.


DAM #2
CROSS SECTION

NOTE —
DAM TO BE CONSTRUCTED IN
STRICT ACCORDANCE WITH PROVISIONS
OUTLINED IN PERMIT ISSUE OF STATE
ENGINEER.

Application No. R-48736 & 48737
Permit No. R-5855 & 36146

RECEIVED
STATE ENGINEER
SALEM, OREGON

PLOT PLAN
1" = 50'

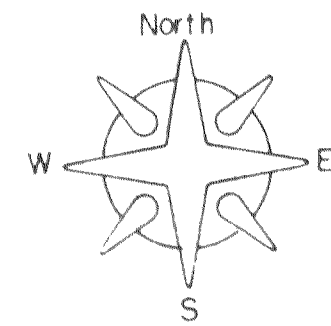

ROADWAY FILL CROSS SEC

HOLDING POND PROFILE
1" = 10'

REVISED 10-1-71 APP'D D.M. & R.E. #2
NOTE: OVERFLOW REVISED 3 SEPT.
F.T.S

NOTE: —
DAM TO BE CONSTRUCTED IN STRICT
ACCORDANCE WITH PROVISIONS OUT-
LINED IN PERMIT ISSUE OF STATE ENGR.

Field Copy

	CENTURY MEADOWS NO. 2 & 3 AURORA, OREGON	
	SANITARY SEWER IMPROVEMENTS	
	CLARK & GROFF ENGINEERS INC. ENGINEERING ARTS BUILDING 3276 Commercial, S. E. SALEM, OREGON	
	DESIGN CLY	DATE FEB 5, 1971

SHEET	OF 11
NO. 71135	