


T.8S., R.5W., W.M.

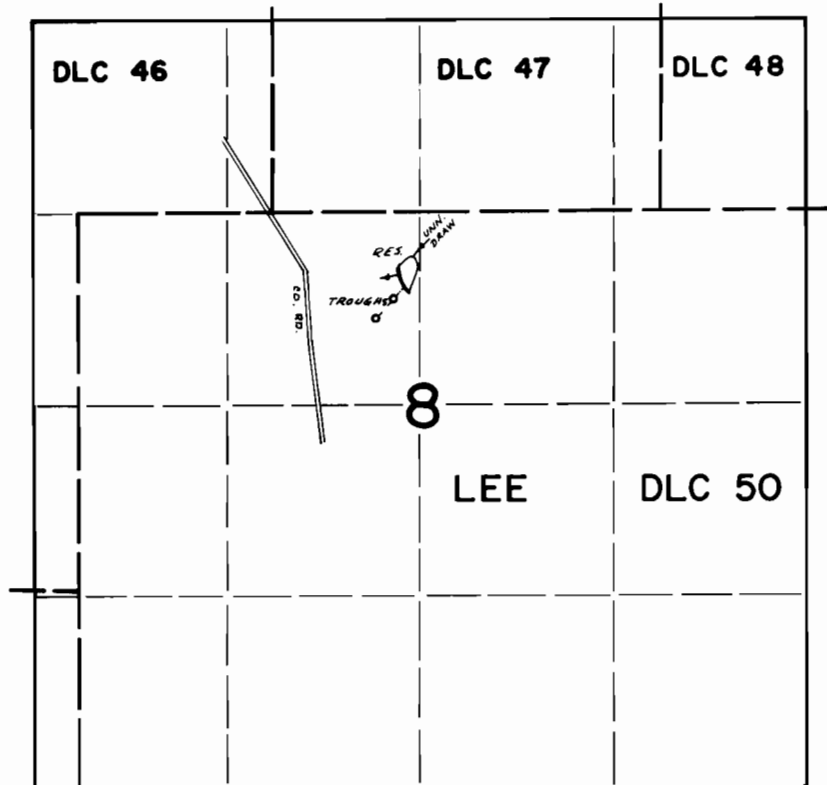

RES. LOC: 430' S 42190' E FROM NW COR LEE DLC 50

**FINAL PROOF SURVEY**  
UNDER

R-47204                      R-5677  
Application No. 47205    Permit No. 35358  
IN NAME OF

JOHN N. HALSTEAD

Surveyed June 10 1975, by D. Norby