



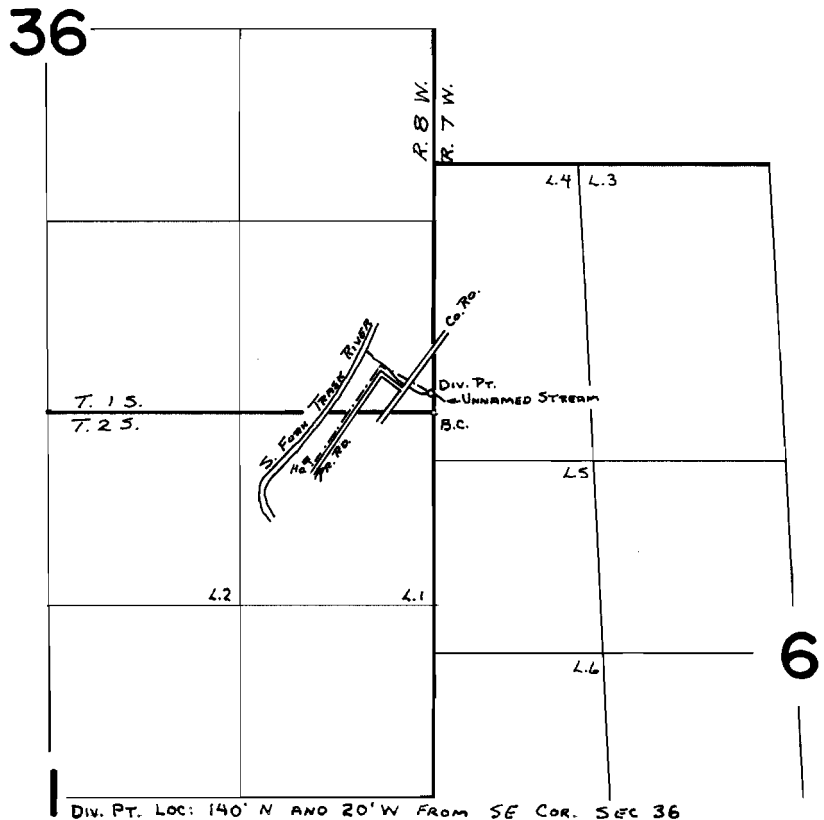

## FINAL PROOF SURVEY UNDER

Application No. 48339 Permit No. 36297  
IN NAME OF

GEORGE W. & BERNEICE A. MANLOVE

Surveyed JUNE 25 1974, by L. TOLL