


G-494
G-4947
43933

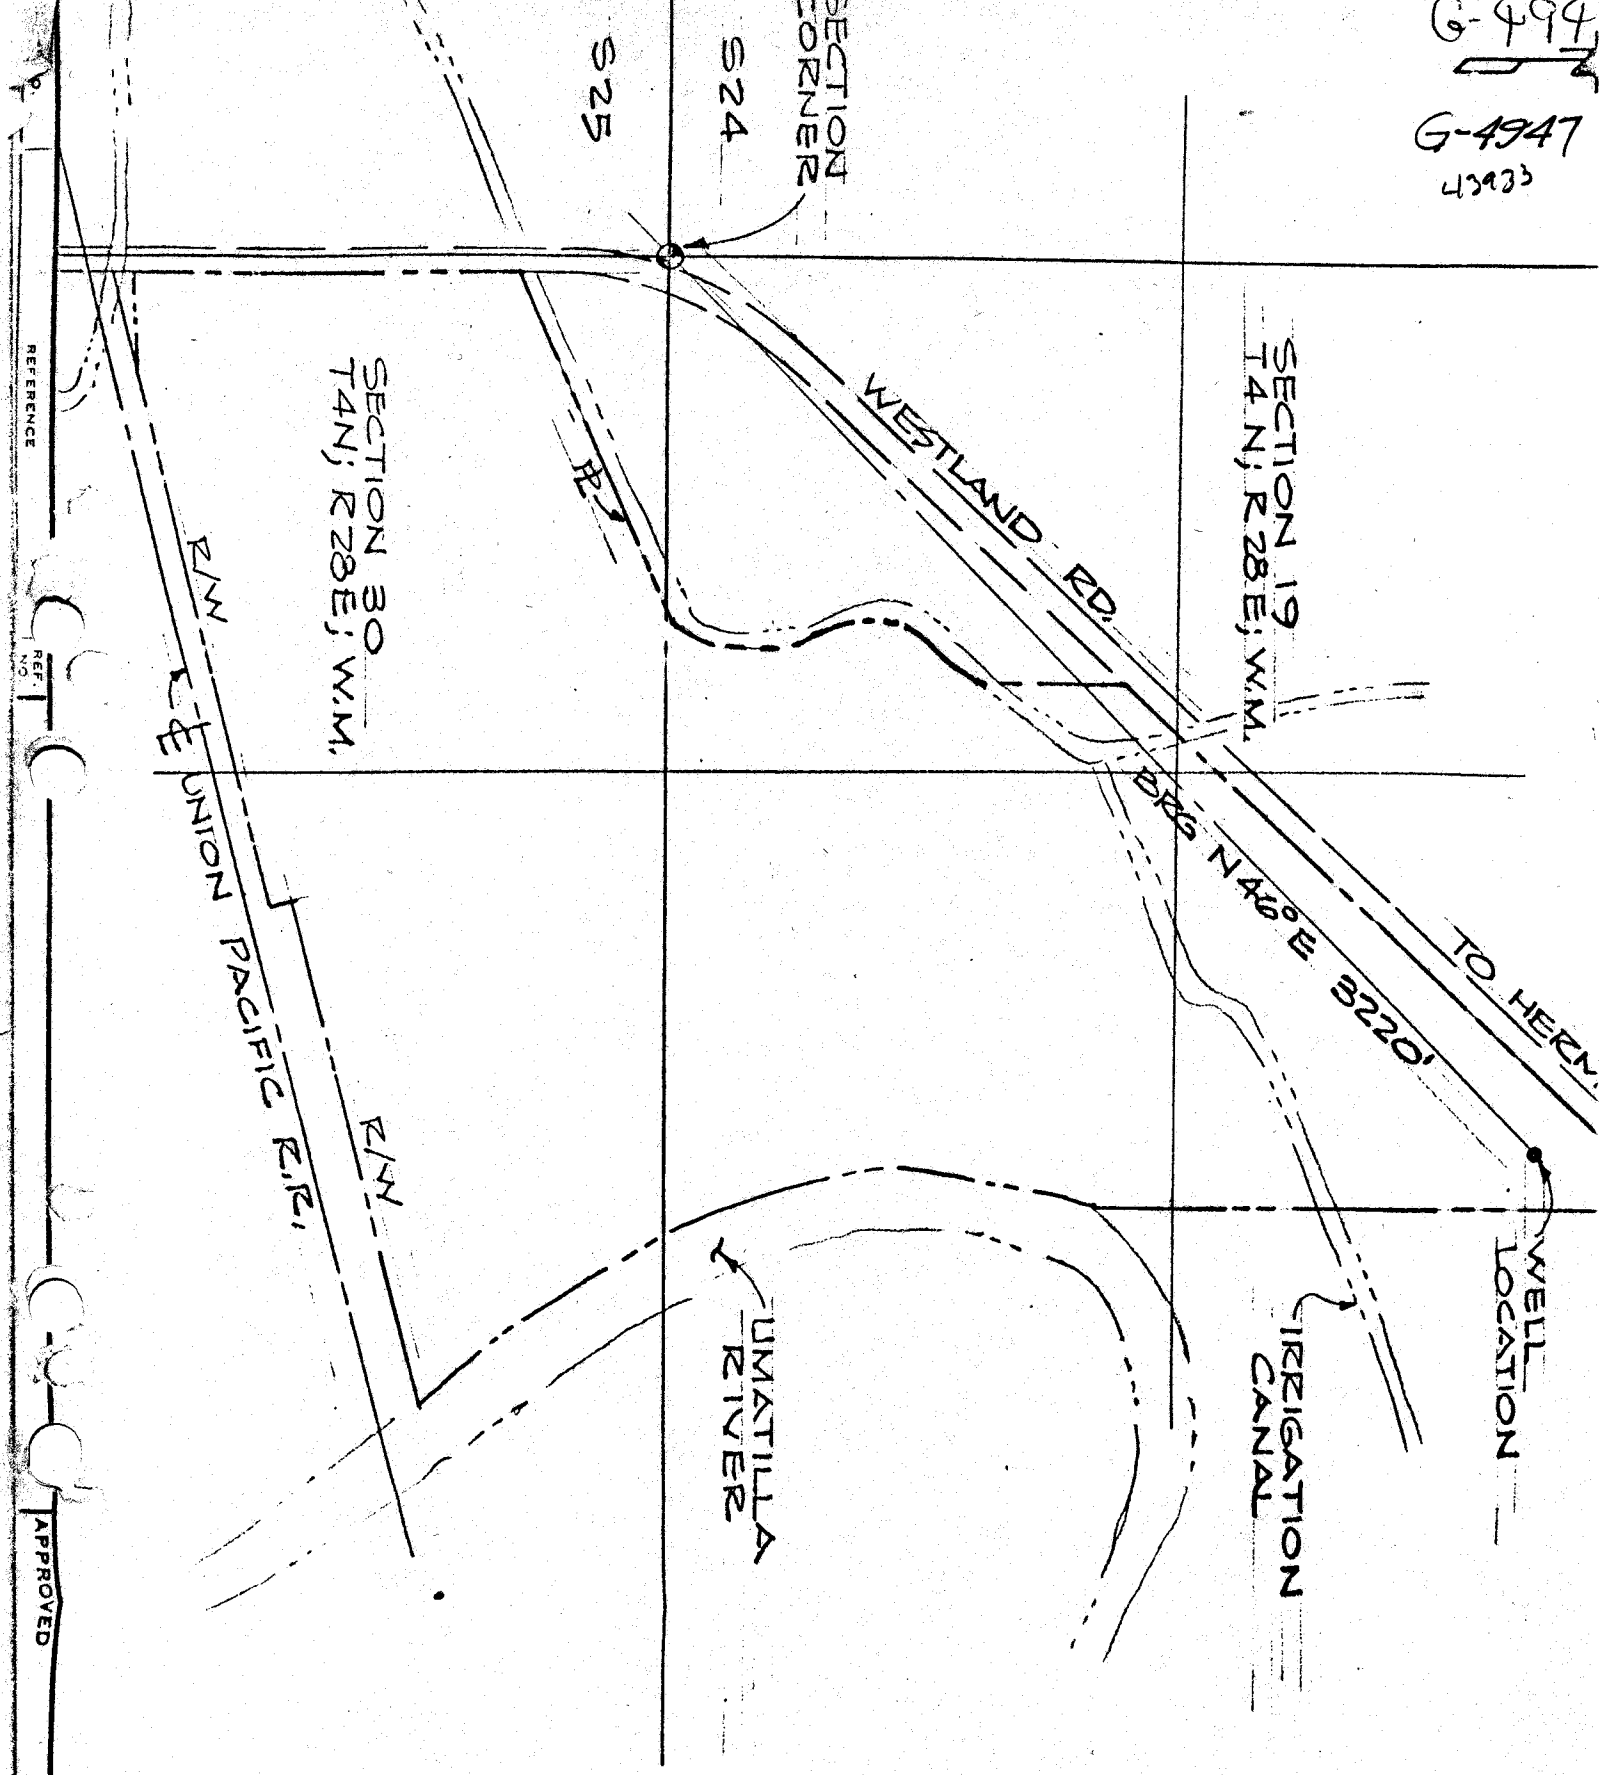

A-G
P-G

REFERENCE

REF. NO.

APPROVED

SCALE